

LAND CORNER RECORDATION CERTIFICATE
Filing Requirement of Act 74, Mich. P.A. 1970

Page 1 of 1
Date 11/23/1999 Time 18:37:41
RECORDING FEE: 9.00

For corners in

Ontonagon County	Located in:	Corner Code #
1. Public Land Survey	T51N R40W	L - 5
	T R	
	T R	
	T R	
2. Property Controlling in Section	S T R	
	S T R	
3. Miscellaneous Property in Sec.	S T R	
	S T R	
4. Lot No.	Recorded Plat	
5. Private Claims		

SURVEY & REMONUMENTATION

MAR 23 2000

SECTION

Register of Deeds Stamp & File Number

	A	B	C	D	E	F	G	H	I	J	K	L	M
1													
2	6	5	4	3	2	1							
3													
4	7	8	9	10	11	12							
5													
6	18	17	16	15	14	13							
7													
8	19	20	21	22	23	24							
9													
10	30	29	28	27	26	25							
11													
12	31	32	33	34	35	36							
13													

I, Joseph C. Domitrovich, in a field survey on November 1, 1999, do hereby state that under requirements of P.A. 74, Michigan P.A. of 1970, the corner points mentioned in lines 1 and 2 above were in conformance with regulations and rules therefore as required in the current manual of survey instructions of the United States Department of the Interior, Bureau of Land Management or by a decree of a Court of Law and /or that the corner points mentioned in lines 3, 4 and 5 above were in conformance with the rules of the Michigan Board of Land Surveyors or by a Decree of a Court of Law; established, re-established, monumented, recovered, found as expressed below:

NOTE: Not more than 2 corners, all in the same town and range, may be recorded on this certificate.

A. Description of original monument and accessories and/or subsequent restoration:

(L - 5) 1/4 corner common to Sections 12 & 13, T51N, R40W.

1845 William A. Burt set an Elm Post with ties:

6" Sugar	N 52°E	67 links
9" Sugar	N 66°W	19 links

1951 Ned Hawley, Timbercruiser, noted in his personal copy of the original field notes that the corner was a 1/2" pipe with a "Big Elm in meadow, S 55°E, 60 pcs."

B. Description of corner evidence found and/or method applied in restoring or reestablishing corner:

I found no remains of the original corner or accessories. I found the iron pipe called for by Hawley. It falls at the correct bearing and distance from the remains of an enormous elm stump in the old Levi Field. The pipe also falls at the Northerly Edge of the old Levi Field which had been farmed before 1900. The pipe has been used and accepted as the 1/4 corner position for at least 48 years. I have accepted it as the best representation of the true 1/4 corner position and have monumented it as such.

Research on file with County Remonumentation Representative.


PEER GROUP APPROVED

Paul W. Anselkamp
COUNTY REPRESENTATIVE 11-09-99

C. Description of monument for corner and accessories established to perpetuate locating the position of the corner:

Corner is a 2 1/2" x 30" aluminum pipe with a 3" diameter aluminum cap stamped to read: County Remonumentation; T51N, R40W; 1/4; S. 12, S. 13; 1999; P.S. 37273. Ties:

10" Soft Maple	N 79°W	31.17'
3" Ash	N 07°W	21.13'
6" Box Elder	N 61°E	12.63'
Steel Sign Post	South	1.04' (to face)
SW Corner Section 12	S 88°39'59"W	2647.40'
SE Corner Section 12	S 89°39'45"E	2600.68'

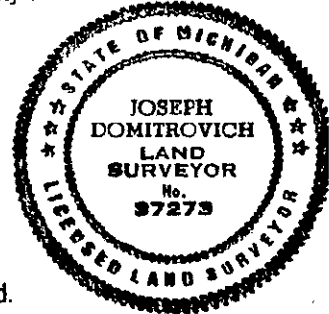

NOTE: Bearings to witness objects are magnetic. Distances are to a nail in side of the witness object unless noted.

Signed by *J. C. Domitrovich*

Date 11/09/99

Surveyor's Michigan License No. 37273