

JUDITH D. ROEHM

Ontonagon County

LAND CORNER RECORDATION CERTIFICATE

Filing Requirement of Act 74, Mich. P.A. 1970

Page 1 of 1
Date 10/27/1999
RECORDING FEE:

11/5/229
Time 10:12

For corners in

Ontonagon County	Located in:	Corner Code #
1. Public Land Survey	T51N R40W	L-7
	T R	
	T R	
	T R	
2. Property Controlling in Section	S T R	
	S T R	
3. Miscellaneous Property in Sec.	S T R	
	S T R	
4. Lot No.	, Recorded Plat	
5. Private Claims		

SURVEY & REMONUMENTATION

MAR 28 2000

SECTION

Register of Deeds Stamp & File Number

	A	B	C	D	E	F	G	H	I	J	K	L	M
1													
2	6	5	4	3	2	1							
3													
4	7	8	9	10	11	12							
5													
6	18	17	16	15	14	13							
7													
8	19	20	21	22	23	24							
9													
10	30	29	28	27	26	25							
11													
12	31	32	33	34	35	36							
13													

I, Joseph C. Domitrovich, in a field survey on September 28, 1999, do hereby state that under requirements of P.A. 74, Michigan P.A. of 1970, the corner points mentioned in lines 1 and 2 above were in conformance with regulations and rules therefore as required in the current manual of survey instructions of the United States Department of the Interior, Bureau of Land Management or by a decree of a Court of Law and /or that the corner points mentioned in lines 3, 4 and 5 above were in conformance with the rules of the Michigan Board of Land Surveyors or by a Decree of a Court of Law; established, re-established, monumented, recovered, found as expressed below:

NOTE: Not more than 2 corners, all in the same town and range, may be recorded on this certificate.

A. Description of original monument and accessories and/or subsequent restoration:

(L-7) 1/2 Corner Common to Sections 13 & 24, T51N, R40W.

1845 William A. Burt set a fir post with ties:

8" Sugar	N 62°E	32 links
12" Hemlock	N 74°W	41 links

1976 Keith L. Sackett, P.S. 19006, for Michigan DNR, re-established corner position by single proportionate measurement. He set a 1" I.D. x 36" I.P. with a 4" aluminum cap. Recorded in L. 1, P.75.

Ties:

4" Sugar	N 37°W	4.4'
4" Sugar	S 10°W	12.8'
3" Sugar	S 67°E	23.9'
3" Sugar	S 26°E	2.6'

DEED GROUP APPROVED
Carl W. Applekamp
COUNTY REGISTER
10-14-99

B. Description of corner evidence found and/or method applied in restoring or reestablishing corner:


I found no remains of the original corner or accessories. I recovered the monument set by Sackett and his 4 bearing trees. Distance from this position to the stream crossing to the West works well with GLO. I accepted Sackett's Monument as found.

Research on file with County Remonumentation Representative.

C. Description of monument for corner and accessories established to perpetuate locating the position of the corner:

Corner is a 1 1/2" O.D. iron pipe with a 4" diameter aluminum DNR cap on it. Ties:

5" Soft Maple	S 63°E	23.93'	(DNR - added nail to side)
4" Hard Maple	S 20°E	2.83'	(DNR - added nail to side)
5" Hard Maple	S 15°W	12.83'	(DNR - added nail to side)
6" Hard Maple	N 38°W	4.54'	(DNR - added nail to side)
Steel sign rail	East	1.10'	(to face)
DNR 1/16 corner	S 89°37'09"E	1316.31'	
SE Corner Sec. 12	S 89°38'05"E	2631.38'	(2636.7 GLO)
SW Corner Sec. 12	N 89°39'13W	2630.65'	(2636.7 GLO)

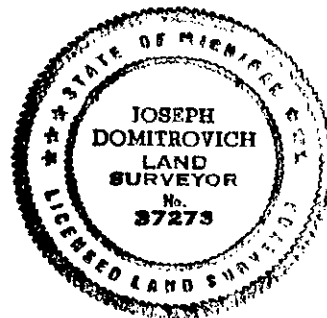

NOTE: Bearings to witness objects are magnetic. Distances are to a nail in side of the witness object unless noted.

Signed by *J.C. Domitrovich*

Date 10-14-99

Surveyor's Michigan License No. 37273