JUDITH O. ROEHM 12/13/96
Ontonagon County 10:46
LC 4/ 240 JEM Fee: 9.00
Page 1 of 1

LAND CORNER RECORDATION CERTIFICATE
Filing Requirement of Act 74, Mich. P.A. 1970

For corners in

Ontonagon (County) Located In: Corner Code #

1. Public Land Survey		T 51N R 39W	A-3 Same	
		T 51N R 40W	M-3 Corner	
		T___ R___		
		T___ R___		
2. Property Controlling	S___	T___ R___		
in Section	S___	T___ R___		
3. Miscellaneous	S___	T___ R___		
Property in Sec.	S___	T___ R___		

SURVEY & REMONUMENTATION
MAY 2 2 1997
COMMISSION
Register of Deeds Stamp & File Number

4. Lot No. _____, Recorded Plat _____
5. Private Claims _____

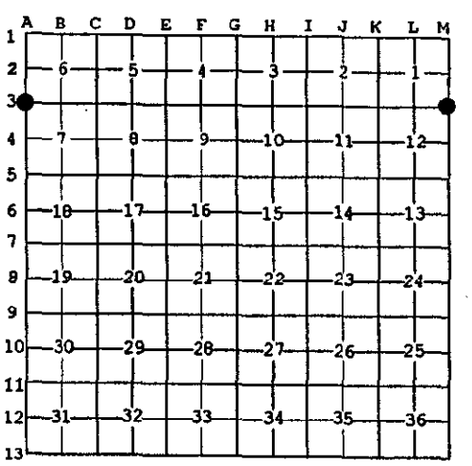

I, Joseph C. Domitrovich, in a field survey on December 4, 19 96 do hereby state that under requirements of P.A. 74, Michigan P.A. of 1970, the corner points mentioned in lines 1 and 2 above were in conformance with regulations and rules therefore as required in the current manual of survey instructions of the United States Department of the Interior, Bureau of Land Management or by a decree of a Court of Law and /or that the corner points mentioned in lines 3, 4 and 5 above were in conformance with the rules of the Michigan Board of Land Surveyors or by a Decree of a Court of Law; established, re-established, monumented, recovered, found as expressed below:

NOTE: Not more than 2 corners, all in the same town and range, may be recorded on this certificate.

(A-3) Corner of Sections 6 & 7, T51N, R39W, and Sections 1& 12, T51N, R40W

A. Description of original monument and accessories and/or subsequent restoration:

1845 - Austin Burt set post.
14" Hemlock S 71° W 16 links
15" Sugar. N 31° W 39 links

1982 - J. Reynolds, timber cruiser, placed aluminum tag on 6" Hard Maple facing a fence corner.

B. Description of corner evidence found and/or method applied in restoring or reestablishing corner:

I found no remains of the original corner or bearing trees.
At the corner position, I found a fallen corner fencepost and old fencelines running East, West and South, from it. I found an aluminum tag on a 6" Hard Maple facing the fence corner with "J. Reynolds, 1982, and Jerry Koski, 1995" written on it.
This fence corner works well with original calls to a stream 3 links wide:
South - 33' GLO; 24' measured
West - 33' GLO and measured
I accepted the fence corner as the Section Corner and monumented it as such.

PEER GROUP APPROVED
Earl W Applekamp
COUNTY REPRESENTATIVE
12-11-96

Research on file with County Remonumentation Representative.
C. Description of monument for corner and accessories established to perpetuate locating the position of the corner:

Corner is a 3/4" x 36" aluminum rod with a 3" diameter aluminum cap stamped to read: S. 1, S. 12, S. 6, S. 7; T.51N, R.40W, R.39W; 1996; P.S. 37273; COUNTY REMONUMENTATION. Corner falls in the bottom of a deep ravine.

Witnesses:

12" Twin Yellow Birch	N 61° E	13.00'	(Existing Blaze)
6" Hard Maple	S 60° E	32.26'	
6" Hard Maple	S 60° W	4.93'	(Existing Blaze & Tag)
7" Hemlock	N 17° W	21.37'	
Steel Sign Post	North	1.11'	

STATE OF MICHIGAN JOSEPH DOMITROVICH LAND SURVEYOR No. 37273 LICENSED LAND SURVEYOR

NOTE: Bearings are magnetic. Distances are to nail in side of witness objects unless noted.
Signed by Joe C. Domitrovich Date 12/10/96
Surveyor's Michigan License No. 37273

FORM APPROVED BY MICHIGAN STATE BOARD OF PROFESSIONAL SURVEYORS, JAN. 28, 1971
REVISED MAY 14,1975
REVISED JAN., 1983
REVISED OCT., 1995