

JUDITH D. BOEHN

Ontonagon County

LAND CORNER RECORDATION CERTIFICATE
Filing Requirement of Act 74, Mich. P.A. 1970

Page 1 of 1
Date 10/27/1999 Time 10:17:11
RECORDING FEE: 3.00

For corners in

Ontonagon County	Located in:	Corner Code #
1. Public Land Survey	T51N R40W	M-4
	T51N R39W	A-4
	T R	
	T R	
2. Property Controlling in Section	S T R	
	S T R	
3. Miscellaneous Property in Sec.	S T R	
	S T R	
4. Lot No.	Recorded Plat	
5. Private Claims		

SURVEY & REMONUMENTATION

MAR 28 2000

SECTION

Register of Deeds Stamp & File Number

	A	B	C	D	E	F	G	H	I	J	K	L	M
1													
2	6	5	4	3	2	1							
3													
4	7	8	9	10	11	12							
5													
6	18	17	16	15	14	13							
7													
8	19	20	21	22	23	24							
9													
10	30	29	28	27	26	25							
11													
12	31	32	33	34	35	36							
13													

I, Joseph C. Domitrovich, in a field survey on October 12, 1999, do hereby state that under requirements of P.A. 74, Michigan P.A. of 1970, the corner points mentioned in lines 1 and 2 above were in conformance with regulations and rules therefore as required in the current manual of survey instructions of the United States Department of the Interior, Bureau of Land Management or by a decree of a Court of Law and for that the corner points mentioned in lines 3, 4 and 5 above were in conformance with the rules of the Michigan Board of Land Surveyors or by a Decree of a Court of Law; established, re-established, monumented, recovered, found as expressed below:

NOTE: Not more than 2 corners, all in the same town and range, may be recorded on this certificate.

A. Description of original monument and accessories and/or subsequent restoration:

(M-4, A-4) 1/4 Corner common to Sections 12, T51N, R40W and 7, T51N, R39W.

1845 Austin Burt set a post with ties:

8" Hemlock	S 77°E	13 links
18" Hemlock	N 78°W	05 links

I found no record of subsequent restoration.

B. Description of corner evidence found and/or method applied in restoring or reestablishing corner:


At the corner position I found a 3/4" x 68" iron pipe. It falls at the correct bearing and distance from the remains of the 18" hemlock, now a 25 +/-" stump, decayed to ground level. A 10" cedar with a "beaver" blaze faces the pipe. I accepted the 3/4" pipe as the 1/4 corner and replaced it with a county monument.

Research on file with County Remonumentation Representative.

C. Description of monument for corner and accessories established to perpetuate locating the position of the corner:

Corner is a 2 1/2" x 30" aluminum pipe with a 3" diameter aluminum cap stamped to read: COUNTY REMONUMENTATION; T.51N., R.40W.; R.39W.; S.12, S.7; 1/4; 1999; P.S. 37273. Ties:

4" Balsam	N 07°E	20.42'
6" Hemlock	N 85°E	21.57'
6" Ash	S 05°E	32.99'
10" Cedar	S 55°W	18.53' (Existing Beaver Blaze)
Steel Sign Rail	West	0.74'
NW Corner Section 7	N 00°15'23"W	2622.76'

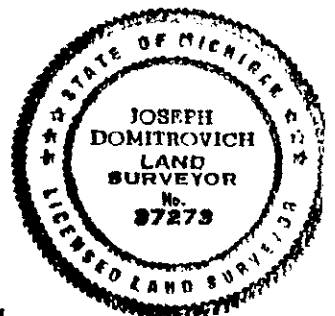

NOTE: Bearings to witness objects are magnetic. Distances are to a nail in side of the witness object unless noted.

PEER GROUP APPROVED

Earl W. Applebaum 10-14-99
COUNTY REMONUMENTATION

Signed by J.C. Domitrovich

Date 10-14-99

Surveyor's Michigan License No. 37273