

LAND CORNER RECORDATION CERTIFICATE
Filing Requirement of Act 74, Mich. P.A. 1970

JUDITH D. ROEMM
 Ontonagon County
 Page 1 of 1
 JEM Date 10/27/1999 Time 10:17:47
 RECORDING FEE: 9.00

For corners in

Ontonagon County Located in: Corner Code #

1. Public Land Survey T51N R40W **M-7**
 T51N R39W A-7

2. Property Controlling S T R
 in Section S T R
 3. Miscellaneous S T R
 Property in Sec. S T R

4. Lot No. , Recorded Plat
 5. Private Claims

**SURVEY &
 REMONUMENTATION**

MAR 23 2000

SECTION

Register of Deeds Stamp & File Number

A	B	C	D	E	F	G	H	I	J	K	L	M
1												
2	6	5	4	3	2	1						
3												
4	7	8	9	10	11	12						
5												
6	18	17	16	15	14	13						
7												
8	19	20	21	22	23	24						
9												
10	30	29	28	27	26	25						
11												
12	31	32	33	34	35	36						
13												

I, Joseph C. Domitrovich, in a field survey on September 28, 1999, do hereby state that under requirements of P.A. 74, Michigan P.A. of 1970, the corner points mentioned in lines 1 and 2 above were in conformance with regulations and rules therefore as required in the current manual of survey instructions of the United States Department of the Interior, Bureau of Land Management or by a decree of a Court of Law and /or that the corner points mentioned in lines 3, 4 and 5 above were in conformance with the rules of the Michigan Board of Land Surveyors or by a Decree of a Court of Law; established, re-established, monumented, recovered, found as expressed below:

NOTE: Not more than 2 corners, all in the same town and range, may be recorded on this certificate.

A. Description of original monument and accessories and/or subsequent restoration:

(M-7, A-7) Corner common to sections 13 & 24, T51N, R40W and 18 & 19, T51N, R39W.

1845 Austin Burt set a post with ties:

10" Sugar S07°W 22 links
 12" Sugar N 67°W 25 links

1949-1950 Ned Hawley, Timber Cruiser, found the 12" Sugar B.T. with a blaze facing Southeast and "Marks faint" on it. He put in a 3/4" x 4" iron pipe with a coupling on top at record bearing and distance from this B.T.

1966 Billy D. Buckler, P.S., for Michigan DNR, found a 3/4" iron pipe with a 30" Hard Maple original B.T. N 67°W, 25 links from it. He also found 1/2" iron pipe N 33°W, 38 links. Ties:

20" Hard Maple S 41°E 37 links (24.42')
 10" Hard Maple S 87°W 85 links (56.1')
 14" Hard Maple N 72°W 67 1/2 links (44.55')

FREE GROUP APPLICANT
Paul W. Applekamp
 COUNTY REMONUMENTATION

B. Description of corner evidence found and/or method applied in restoring or reestablishing corner:

10-14-99


I recovered a 3/4" iron pipe with a coupling on top at the corner position as called for by Ned Hawley. It was at the correct bearing and distance from the 12" Sugar B.T. (Now a 30" fallen Hard Maple.) I also recovered 2 of Billy Buckler's B.T.'s which indicate he used and accepted this same pipe. I also found another 5/8" iron pipe N 30°W, 25.08' from the corner. This also was set by Ned Hawley (in 1955) N 07°E, 22 links from the same existing B.T. He was unsure whether the existing B.T. was the 10" or 12" Sugar. I cut open the grown over portions of the fallen B.T. The remaining part of the blaze faced southeast supporting Hawley's original conclusion, and Billy Buckler's, that this B.T. was the 12" Sugar and that the 3/4" iron pipe is at the correct corner position. I replaced the pipe with a county monument.

Research on file with County Remonumentation Representative.

C. Description of monument for corner and accessories established to perpetuate locating the position of the corner:

Corner is a 3/4" x 48" aluminum rod with a 3" diameter aluminum cap stamped to read: COUNTY REMONUMENTATION; T51N., R.40W. R.39W; S. 13, S. 24, S. 18, S. 19; 1999; P.S. 37273. Corner falls 74' +/- North of the foot of the steep ridge to the South. Ties:

25" Hard Maple S 38°E 24.53' (DNR- added nail)
 Steel sign rail South 1.18' (to face)
 18" Hard Maple S 38°W 55.48' (Ex. Blaze - added nail)
 20" Hard Maple S 83°W 53.56'
 20" Hard Maple N 12°W 44.63' (DNR- added nail)
 S 1/4 Corner Section 13 N 89°38'05"W 2631.38' (2636.7' GLO)
 S 1/4 Corner Section 18 N 89°20'16"E 2723.41' (2734.38' GLO)

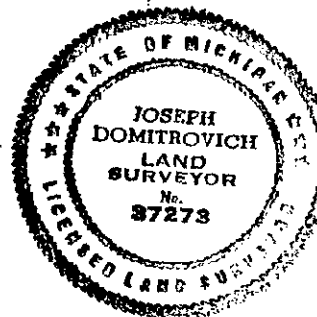

NOTE: Bearings to witness objects are magnetic. Distances are to a nail in side of the witness object unless noted.

Signed by Joseph C. Domitrovich

Date 10-14-99

Surveyor's Michigan License No. 37273