

LAND CORNER RECORDATION CERTIFICATE
 Filing Requirement of Act 74, Mich. P.A. 1970

For corners in

<u>ONTONAGON</u> (County)	Located In:	Corner Code #
1. Public Land Survey	T51NR 41W	F-3
	T ___ R ___	_____
	T ___ R ___	_____
2. Property Controlling in Section	S ___ T ___	_____
	S ___ T ___	_____
3. Miscellaneous Property in Sec.	S ___ T ___	_____
	S ___ T ___	_____


**SURVEY &
 REMONUMENTATION**

MAR 23 2000

SECTION

Register of Deeds Stamp & File Number

4. Lot No. _____, Recorded Plat _____
 5. Private Claims _____

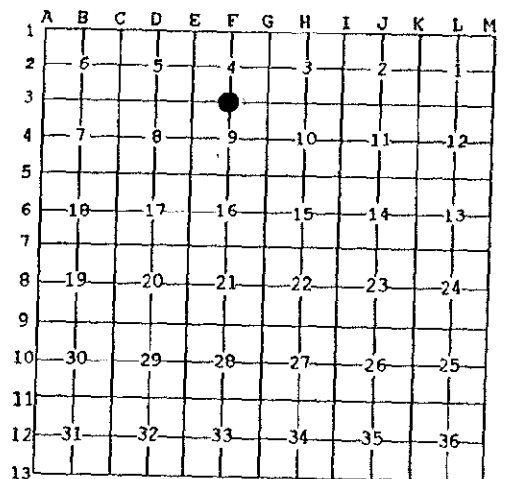

1/4 Corner common to Sections 4 & 9, T51N R41W.

I, Earl W. Applekamp, in a field survey on Nov. 26, 19 99 do hereby state that under requirements of P.A. 74, Michigan P.A. of 1970, the corner points mentioned in lines 1 and 2 above were in conformance with regulations and rules therefore as required in the current manual of survey instructions of the United States Department of the Interior, Bureau of Land Management or by a decree of a Court of Law and /or that the corner points mentioned in lines 3, 4 and 5 above were in conformance with the rules of the Michigan Board of Land Surveyors or by a Decree of a Court of Law; established, re-established, monumented, recovered, found as expressed below:

NOTE: Not more than 2 corners, all in the same town and range, may be recorded on this certificate.

A. Description of original monument and accessories and/or subsequent restoration:

Original Corner established by Sylvester Higgins, U.S. Deputy Surveyor, May 1846. Set Wood Post. ORIGINAL BEARING TREES: 18" Y. Birch S20°E, 12 Links (7.92 Feet), 6" Y. Birch, N58°W, 3 Links (1.98 Feet). Corner was re-established by Billy D. Buckler, R.L.S. No. 08887 on September 23, 1965. He did not find any original evidence. He set a 1" pipe with a 4" aluminum cap midway and on line between opposite Section Corners, East & West. He established two bearing trees, a 5" Hard Maple, N18°W, 14.6 Feet, a 5" Y. Birch, S85°W, 7.1 feet. The Corner was not recorded. Bucklers bearing trees were still in place.

B. Description of corner evidence found and/or method applied in restoring or reestablishing corner.

I found the 1" pipe with a 4" cap set by Buckler. The monument was in good condition. I accepted the monument established by Buckler and added four bearing objects.

Research on file with the Ontonagon County Remonumentation Program Representative.

PEER GROUP APPROVED
Earl W. Applekamp
 COUNTY Notary Public
 12-20-99

C. Description of monument for corner and accessories established to perpetuate locating the position of the corner:

The 4" aluminum cap on the monument described above is stamped to read: MICHIGAN DEPT. OF CONSERVATION, T51N, R41W, S4, S9, 1/4, STATE FOREST.

I established the following bearing objects:

Nail in 6" Maple N88°W 14.10' - Nail in 9" Maple N66°E 28.95'
 Nail in 6" H. Maple, N21°W 28.58' - 6' Steel Sign Post, North 0.72'
 Centerline Hwy. M-64 South 66.8'



Signed by Earl W. Applekamp
 Surveyor's Michigan License No. 17610

Date December 13, 1999