

LAND CORNER RECORDATION CERTIFICATE
 Filing Requirement of Act 74, Mich. P.A. 1970

For corners in
ONTONAGON
 (County)

Located in: T51NR 41W Corner Code # G-3


1. Public Land Survey
 T ___ R ___
 T ___ R ___
 T ___ R ___

2. Property Controlling in Section
 S ___ T ___ R ___
 S ___ T ___ R ___

3. Miscellaneous Property in Sec.
 S ___ T ___ R ___

SURVEY &
 REMONUMENTATION
 MAR 23 2000
 SECTION
 Register of Deeds Stamp & File Number

4. Lot No. _____, Recorded Plat _____
 5. Private Claims _____
 Section Corner common to Sections 3, 4, 9 & 10, T51N R41W.

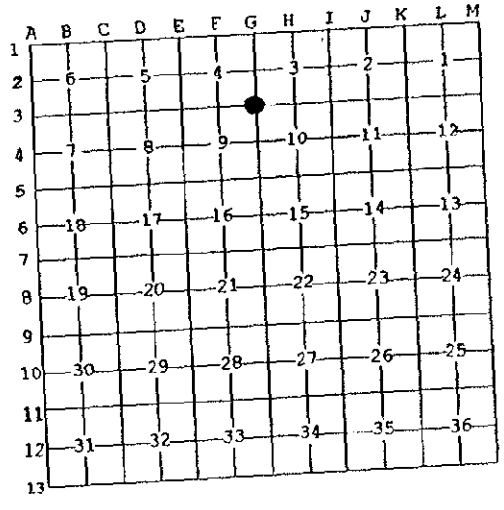

I, Earl W. Applekamp, in a field survey on Nov. 26, 19 99 do hereby state that under requirements of P.A. 74, Michigan P.A. of 1970, the corner points mentioned in lines 1 and 2 above were in conformance with regulations and rules therefore as required in the current manual of survey instructions of the United States Department of the Interior, Bureau of Land Management or by a decree of a Court of Law and for that the corner points mentioned in lines 3, 4 and 5 above were in conformance with the rules of the Michigan Board of Land Surveyors or by a Decree of a Court of Law, established, re-established, monumented, recovered, found as expressed below:

NOTE: Not more than 2 corners, all in the same town and range, may be recorded on this certificate.

A. Description of original monument and accessories and/or subsequent restoration:
 Original Corner established by Sylvester Higgins, U.S. Deputy Surveyor, May 1846. Set Wood Post. ORIGINAL BEARING TREES: 16" Sugar, S40°W, 24 Links (15.84 Feet), 24" Hemlock, N38°E, 18 Links (11.88 Feet). Corner was re-established by Billy D. Buckler, R.L.S. No. 08887 on June 3, 1965. He did not find any original evidence, but used existing evidence. He set a 1 1/4" X 36" pipe with a 4" aluminum cap. He established two bearing trees, a 13" W. Pine, N58°E, 46.0 Feet, a 10" Red Pine, S69°E, 32.4 Feet. He did not record the corner.

B. Description of corner evidence found and/or method applied in restoring or reestablishing corner:
 I found the 1 1/2" pipe with 4" cap set by Billy D. Buckler. A large tree had fallen on the pipe and broke the cap. The bearing trees were still in place. I replaced the 1 1/4" pipe with a monument as shown in "C" below.

Research on file with the Ontonagon County Remonumentation Program Representative.

C. Description of monument for corner and accessories established to perpetuate locating the position of the corner:
 At the corner position I set a 2 1/2" X 30" split base aluminum pipe with a 3" cap stamped to read: County Remonumentation, T51N, R41W, S3, S4, S9, S10, 1999, P.S. 17610. I established three additional bearing trees and a reference object.

- Nail in 8" Red Pine S47°W 39.52' - Nail in 11" W. Pine S86°E 50.73'
- Nail in 16" Red Pine N51°E 66.03' - 6' Steel Sign Post, North 0.83'

PEER GROUP APPROVED
Earl W. Applekamp
 COUNTY 12-20-99



Signed by Earl W. Applekamp
 Surveyor's Michigan License No. 17610

Date December 13, 1999