

LAND CORNER RECORDATION CERTIFICATE
 Filing Requirement of Act 74, Mich. P.A. 1970


For corners in

Ontonagon Located In: _____ Corner Code # _____
 (County)

1. Public Land Survey T 51NR 41W _____ I-3 _____
 T _____ R _____ _____
 T _____ R _____ _____
 T _____ R _____ _____

2. Property Controlling S _____ T _____ R _____
 in Section S _____ T _____ R _____
 3. Miscellaneous S _____ T _____ R _____
 Property in Sec. S _____ T _____ R _____

4. Lot No. _____, Recorded Plat _____
 5. Private Claims _____

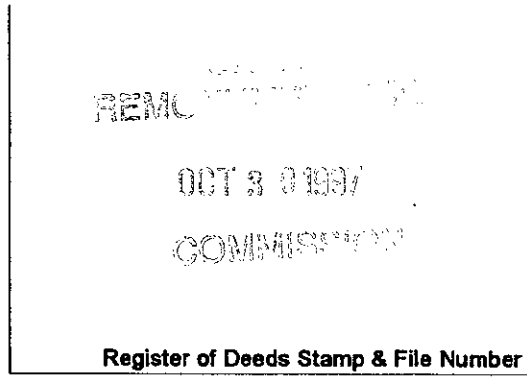

I, Joseph C. Domitrovich, in a field survey on May 1, 19 97 do hereby state that under requirements of P.A. 74, Michigan P.A. of 1970, the corner points mentioned in lines 1 and 2 above were in conformance with regulations and rules therefore as required in the current manual of survey instructions of the United States Department of the Interior, Bureau of Land Management or by a decree of a Court of Law and /or that the corner points mentioned in lines 3, 4 and 5 above were in conformance with the rules of the Michigan Board of Land Surveyors or by a Decree of a Court of Law, established, re-established, monumented, recovered, found as expressed below:

NOTE: Not more than 2 corners, all in the same town and range, may be recorded on this certificate.

	A	B	C	D	E	F	G	H	I	J	K	L	M
1													
2	6		5		4		3		2		1		
3									●				
4	7		8		9		10		11		12		
5													
6	18		17		16		15		14		13		
7													
8	19		20		21		22		23		24		
9													
10	30		29		28		27		26		25		
11													
12	31		32		33		34		35		36		
13													

(I-3) Corner of Sections 2, 3, 10 and 11, T51N, R41W

A. Description of original monument and accessories and/or subsequent restoration:

- 1847 - S.W. Higgins set post, 10" Hemlock S 40° W 26 links
 10" Cedar N 33° E 7 links
- 1962 - Michigan State Highway Dept., M-64 Highway plans show 1 1/2" iron pin: ties:
 5" White Birch S 75° W 43.65'
 2" Maple East 16.98'
 4" W Birch South 10.80'

They also show angle and distance of survey centerline and distances south to (1/64th ?) corner and 1/4 corner.

- 1965 - Billy D. Buckler P.S. 8887, found 1" iron rod "believed set by Mr. Wilcox, Rd. Engineer circa 1930. Ties:
 8" Soft Maple S 78° E 69.0', 5" Soft Maple S 35° E 35.2', 1/2" iron (set) South 15.0'

B. Description of corner evidence found and/or method applied in restoring or reestablishing corner:

I found no remains of the original corner or accessories due to shoreline erosion. Erosion has also washed out the M.S.H.D. and Buckler iron pin. I was unable to determine which of the remaining trees in the area were the M.S.H.D. or Buckler accessories. I therefore re-established corner position using information from M-64 Highway plans. This corner works well with other corners in the area as well as with occupation lines of numerous narrow parcels to the east and west.

PEER GROUP APPROVED
Paul W. Applebaum
 COUNTY REPRESENTATIVE 5-12-97

Research on file with County Remonumentation Representative.

C. Description of monument for corner and accessories established to perpetuate locating the position of the corner:

Corner is a 3/4" x 7" aluminum rod with a 3" diameter aluminum cap stamped to read: County Remonumentation: T.51N., R.41W.; S. 3, S. 2, S. 10, S. 11; 1997; P.S. 37273. Corner falls on the extension of a drainage ditch to the south and at the Highwater mark of Lake Superior.

Witnesses

- | | | |
|-------------------------|-----------------|------------------------------|
| Clump of 8" Soft Maples | S 78° E | 67.76' (P.K. nail set) |
| 8" Soft Maple | S 38° E | 30.38' |
| Steel Sign Post | South | 4.40' (to face) |
| 10" Soft Maple | S 37° W | 45.62' |
| 3/4" Iron Pin | S 02° 05' 07" W | 673.78' (673.78' M.S.H.D.) |
| 1/4 Corner S. 10 & 11 | S 02° 05' 07" W | 2630.84' (2632.58' M.S.H.D.) |

NOTE: Bearings are magnetic. Distances are to nail in side of witness objects unless noted.

Signed by John C. Domitrovich Date 5/12/97

Surveyor's Michigan License No. 37273

