

LAND CORNER RECORDATION CERTIFICATE
Filing Requirement of Act 74, Mich. P.A. 1970

For corners in

<u>Ontonagon</u> (County)	Located In:	Corner Code #
1. Public Land Survey	T <u>51N</u> R <u>41W</u>	<u>1-4</u>
	T ___ R ___	_____
	T ___ R ___	_____
	T ___ R ___	_____
2. Property Controlling in Section	S ___ T ___ R ___	_____
	S ___ T ___ R ___	_____
3. Miscellaneous Property in Sec.	S ___ T ___ R ___	_____
	S ___ T ___ R ___	_____

REMC

OCT 3 0 1997

COMMISSION

Register of Deeds Stamp & File Number

4. Lot No. _____, Recorded Plat _____
 5. Private Claims _____

I, Joseph C. Domitrovich, in a field survey on May 1, 19 97 do hereby state that under requirements of P.A. 74, Michigan P.A. of 1970, the corner points mentioned in lines 1 and 2 above were in conformance with regulations and rules therefore as required in the current manual of survey instructions of the United States Department of the Interior, Bureau of Land Management or by a decree of a Court of Law and /or that the corner points mentioned in lines 3, 4 and 5 above were in conformance with the rules of the Michigan Board of Land Surveyors or by a Decree of a Court of Law; established, re-established, monumented, recovered, found as expressed below:

NOTE: Not more than 2 corners, all in the same town and range, may be recorded on this certificate.

A	B	C	D	E	F	G	H	I	J	K	L	M
1												
2	6	5	4	3	2	1						
3												
4	7	8	9	10	11	12						
5												
6	18	17	16	15	14	13						
7												
8	19	20	21	22	23	24						
9												
10	30	29	28	27	26	25						
11												
12	31	32	33	34	35	36						
13												

(1-4) 1/4 Corner Sections 10 & 11, T51N, R41W

A. Description of original monument and accessories and/or subsequent restoration:

- 1846 - S. W. Highness, set post,
 24" Hemlock N 66° E 18 links
 20" Hemlock S 60° W 28 links
- 1962 - Michigan State Highway Department, M-64 Highway Plans show a 2" iron pipe and show angle and distance off of survey centerline as well as distances to corners to the North. Ties:
 3" Poplar N 70° W 2.25'
 4" Poplar S 20° E 8.08'
 8" Poplar S 60° E 18.49'

B. Description of corner evidence found and/or method applied in restoring or reestablishing corner:

I found no remains of original corner or accessories. Corner now falls in heavily clearcut area. I found a 2" iron pipe as called for by M.S.H.D. as well as the stumps of M.S.H.D. bearing trees. This corner works well with M.S.H.D. angle and distance off of M-64 centerline, and well with other corners in area. I accepted the iron pipe as the 1/4 corner and placed 3/4" aluminum rod and cap inside of it.

Research on file with County Remonumentation Representative.

C. Description of monument for corner and accessories established to perpetuate locating the position of the corner:

Corner is a 2" diameter iron pipe with a 3/4" x 36" aluminum rod driven in side of it, with a 3" diameter aluminum cap stamped to read: County Remonumentation; T51N, R41W, 1/4; S.10, S.11; 1997; P.S. 37273.


Witnesses

- 4" Poplar N 25° E 20.05;
- 3" Poplar S 80° E 21.48'
- 3" Poplar S 07° E 4.04'
- Steel Sign Post South 0.88' (to face)
- 7" Soft Maple N 40° W 23.96'
- Cor. Sec. 2, 3, 10 & 11 N 02° 05' 07" W 2630.84'

PEER GROUP APPROVED

Carl W. Appenkamp
 COUNTY REPRESENTATIVE

5-12-97

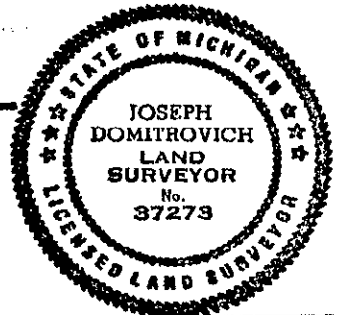

NOTE: Bearings are magnetic. Distances are to nail in side of witness objects unless noted.

Signed by Joseph C. Domitrovich
 Surveyor's Michigan License No. 37273

Date 5/12/97