

LAND CORNER RECORDATION CERTIFICATE
Filing Requirement of Act 74, Mich. P.A. 1970

OCT 30 1997

For corners in

Ontonagon Located In: Corner Code #
(County)

1. Public Land Survey T 51N R 40W A-5 Same
T 51N R 41W M-5 ✓ Corner
T R
T R

2. Property Controlling S T R
in Section S T R

3. Miscellaneous S T R
Property in Sec. S T R

COMMISSION

JUDITH D. ROEHL 06/13/97
Ontonagon County 15:31
LC 47 286 JJT Fee: 9.00
Page 1 of 1

Register of Deeds Stamp & File Number

4. Lot No. _____, Recorded Plat _____
5. Private Claims _____

I, Joseph C. Domitrovich, in a field survey on June 4, 19 97, do hereby state that under requirements of P.A. 74, Michigan P.A. of 1970, the corner points mentioned in lines 1 and 2 above were in conformance with regulations and rules therefore as required in the current manual of survey instructions of the United States Department of the Interior, Bureau of Land Management or by a decree of a Court of Law and/or that the corner points mentioned in lines 3, 4 and 5 above were in conformance with the rules of the Michigan Board of Land Surveyors or by a Decree of a Court of Law; established, re-established, monumented, recovered, found as expressed below:

NOTE: Not more than 2 corners, all in the same town and range, may be recorded on this certificate.

	A	B	C	D	E	F	G	H	I	J	K	L	M
1													
2		6		5		4		3		2		1	
3													
4		7		8		9		10		11		12	
5													
6		18		17		16		15		14		13	
7													
8		19		20		21		22		23		24	
9													
10		30		29		28		27		26		25	
11													
12		31		32		33		34		35		36	
13													

(A-5/M-5) Corner of Sections 12, 7, 13 and 18, T 51N, R40/41W

A. Description of original monument and accessories and/or subsequent restoration:

1845 - Austin Burt, D.S., set post
34" Hemlock S 43° W 56 links
14" Maple N 69° W 33 links

B. Description of corner evidence found and/or method applied in restoring or reestablishing corner:

Original corner and accessories have been destroyed by road construction. The corner falls in an area where Townline Road begins to curve to bypass a ravine. Gravel Hokkanen Road runs to the East, and a woods road runs to the West. I re-established the corner position at the intersection of the centerline of Hokkanen Road to the East and distant centerline of Townline Road. Corner falls in the middle of the Southbound lane of Townline Road, on a curve.

This corner works well with corners to North and South.

Research on file with County Remonumentation Representative.


C. Description of monument for corner and accessories established to perpetuate locating the position of the corner:

Corner is a 5/8" iron pin with a 3" diameter aluminum cap stamped to read: COUNTY REMONUMENTATION, T. 51N, R. 40W, R. 41W; S. 12, S. 7, S. 13, S. 18; 1997; P.S. 37273. I also placed a reference monument (R. M.) to the Southwest, a 2" x 30" aluminum pipe with a 3" diameter aluminum cap, stamped to indicate that the corner is N 51° W 39.76'.

Witnesses:

7" Hard Maple N 74° W 78.52'
Power Pole N 28° W 102.11'
4" Hard Maple S 70° E 65.43'
Reference Monument S 51° 08' 27" W 39.76'
NW Corner Sec. 18 N 00° 16' 55" E 2625.23'
SW Corner Sec. 18 S 00° 11' 42" W 2640.31'

PEER GROUP APPROVED
Earl W. Applekamp
COUNTY REPRESENTATIVE 6-10-97

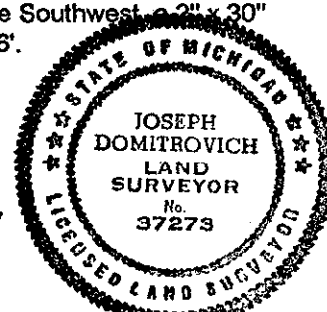

NOTE: Bearings are magnetic. Distances are to nail in side of witness objects unless noted.
Signed by Joseph C. Domitrovich Date 6/9/97

Surveyor's Michigan License No. 37273