

LAND CORNER RECORDATION CERTIFICATE
Filing Requirement of Act 74, Mich. P.A. 1970

For corners in Ontonagon Located In: _____ Corner Code # _____
 (County)

1. Public Land Survey T 51N R 41W M-6
 T 51 R 40W A-6
 T _____ R _____
 T _____ R _____

2. Property Controlling S _____ T _____ R _____
 in Section S _____ T _____ R _____

3. Miscellaneous S _____ T _____ R _____
 Property in Section S _____ T _____ R _____

**SURVEY &
 REMONUMENTATION**

MAY 22 1997

COMMISSION

Register of Deeds Stamp & File Number

4. Lot No. _____, Recorded Plat _____
 5. Private Claims _____

One-quarter section corner common to Sections 13 and 18, T51N, R41W.

I, John R. Garske, in a field survey on July 17, 1996, do hereby certify that under requirements of P.A. 74, Michigan P.A. of 1970, the corner points mentioned in lines 1 and 2 above were in conformance with regulations and rules therefore as required in the current manual of survey instructions of the United States Department of the Interior, Bureau of Land Management or by a decree of a Court of Law and/or that the corner points mentioned in lines 3, 4 and 5 above were in conformance with the rules of the Michigan Board of Professional Surveyors or by a Decree of a Court of Law; established, re-established, monumented, re-monumented, recovered, found as expressed below:

A	B	C	D	E	F	G	H	I	J	K	L
2	6	5	4	3	2						
3											
4	7	8	9	10	11	12					
5											
6	18	17	16	15	14	13					
7											
8	19	20	21	22	23	24					
9											
10	30	29	28	27	26	25					
11											
12	31	32	33	34	35	36					
13											

NOTE: Not more than 4 corners, all in the same town and range, may be recorded on this certificate.


A. Description of original monument and accessories and/or subsequent restoration:

In 1845 Austin Burt, U.S. Deputy Surveyor, set a wooden post from which a 16" sugar bears S40°W, 55 links (36.3') and a 16" hemlock N75°E - 17 links (11.22').

B. Description of corner evidence found and/or method applied in restoring or reestablishing corner:

I found a P.K. nail at the centerline intersection of Halfway and Townline Roads. This position fits well with local occupation lines and has been used and accepted in other surveys. Distances north and south to accepted corners were used to verify the P.K. nail position.

Record research on file.

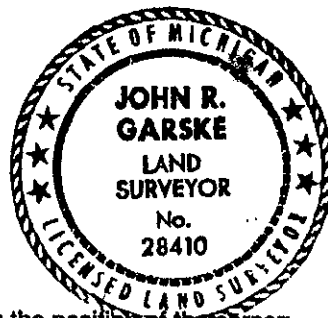

C. Description of monument for corner and accessories established to perpetuate locating the position of the corner:

I established the following reference objects:
 P. pole - S32°E - 47.06 feet
 A 2 1/2" aluminum pipe with 3 1/4" aluminum cap stamped: county remonumentation, T51N, R41W-R40W, R.M., S-13, S-18, 1/4, 1996, R.L.S. 28410, S61°W, 52.13' with steel sign rail - 1.04 feet away.
 Another stamped the same as above except N52°E, 37.91 feet with steel rail 1.0 feet away.

PEER GROUP APPROVED
Earl W. Applekamp 8-14-96
 COUNTY REPRESENTATIVE

SEE SKETCH ON BACK

Signed by John R. Garske
 Surveyor's Michigan License No. 28410

Date 8-14-96