


**LAND CORNER RECORDATION CERTIFICATE**  
 Filing Requirement of Act 74, Mich. P.A. 1970

For corners in

<u>ONTONAGON</u> (County)	Located In:	Corner Code #
1. Public Land Survey	T51N R42W	<u>K-7</u>
	T ___ R ___	_____
	T ___ R ___	_____
	T ___ R ___	_____
2. Property Controlling in Section	S ___ T ___ R ___	_____
	S ___ T ___ R ___	_____
3. Miscellaneous Property in Sec.	S ___ T ___ R ___	_____
	S ___ T ___ R ___	_____

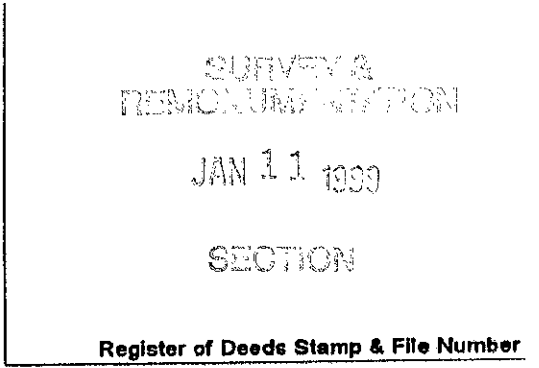

4. Lot No. \_\_\_\_\_, Recorded Plat \_\_\_\_\_  
 5. Private Claims \_\_\_\_\_

Section Corner common to Sections 13, 14, 23 & 24, T51N R42W.

I, Earl W. Applekamp, in a field survey on April 10, 1998 do hereby state that under requirements of P.A. 74, Michigan P.A. of 1970, the corner points mentioned in lines 1 and 2 above were in conformance with regulations and rules therefore as required in the current manual of survey instructions of the United States Department of the Interior, Bureau of Land Management or by a decree of a Court of Law and /or that the corner points mentioned in lines 3, 4 and 5 above were in conformance with the rules of the Michigan Board of Land Surveyors or by a Decree of a Court of Law; established, re-established, monumented, recovered, found as expressed below:

NOTE: Not more than 2 corners, all in the same town and range, may be recorded on this certificate.

1	A	B	C	D	E	F	G	H	I	J	K	L
2		6		5		4		3		2		1
3												
4		7		8		9		10		11		12
5												
6		18		17		16		15		14		13
7												
8		19		20		21		22		23		24
9												
10		30		29		28		27		26		25
11												
12		31		32		33		34		35		36
13												

A. Description of original monument and accessories and/or subsequent restoration:

Original corner established by S. W. Higgins, U.S. Deputy Surveyor, Summer of 1846. Set wood post.

ORIGINAL BEARING TREES:

8" Tamarack	S60°W	19.80 feet
10" Tamarack	N20°E	16.50 feet

PEER GROUP APPROVED  
*Earl W. Applekamp*  
 COUNTY REGISTERED  
 5-13-98

B. Description of corner evidence found and/or method applied in restoring or reestablishing corner:

No original evidence was found. Near the theoretical corner position I found a squared cedar post standing and the remains of an older post on the ground about 10 feet North of the standing post. This position was in conformance with the original survey calls to the Little Iron River and a small stream. This position is also in conformance to corners North, South and East. I re-established the corner at the position of the older post as being the only logical position.

Research on file with the Ontonagon County Remonumentation Program Representative.

C. Description of monument for corner and accessories established to perpetuate locating the position of the corner:

At the corner position I set a 2 1/2"x30" split base aluminum pipe with a 3" cap stamped to read: County Remonumentation, T51N R42W, S13, S14, S23, S24, 1998, P.S. 17610. I established 3 bearing trees and a reference object.

Nail in 6" Maple	N32°W	13.10'	-	Nail in 6" Maple	S16°W	32.50'
Nail in 5" Maple	N55°E	25.84'	-	6' Steel Sign Post	South	0.70'



Signed by Earl W. Applekamp  
 Surveyor's Michigan License No. 17610

Date April 24, 1998