

LAND CORNER RECORDATION CERTIFICATE
 Filing Requirement of Act 74, Mich. P.A. 1970

For corners in

| | | |
|---------------------------------------|----------------|---------------|
| <u>ONTONAGON</u> (County) | Located In: | Corner Code # |
| 1. Public Land Survey | T51N R42W | K-9 |
| | T___ R___ | _____ |
| | T___ R___ | _____ |
| | T___ R___ | _____ |
| 2. Property Controlling in Section | S___ T___ R___ | _____ |
| | S___ T___ R___ | _____ |
| 3. Miscellaneous Property in Sec. | S___ T___ R___ | _____ |
| | S___ T___ R___ | _____ |

SURVEY &
 REMONUMENTATION

JAN 11 1999

SECTION

Register of Deeds Stamp & File Number

4. Lot No. _____, Recorded Plat _____
 5. Private Claims _____

Section Corner common to Sections 23, 24, 25 & 26, T51N R42W.

I, Earl W. Applekamp, in a field survey on April 04, 1998 do hereby state that under requirements of P.A. 74, Michigan P.A. of 1970, the corner points mentioned in lines 1 and 2 above were in conformance with regulations and rules therefore as required in the current manual of survey instructions of the United States Department of the Interior, Bureau of Land Management or by a decree of a Court of Law and/or that the corner points mentioned in lines 3, 4 and 5 above were in conformance with the rules of the Michigan Board of Land Surveyors or by a Decree of a Court of Law; established, re-established, monumented, recovered, found as expressed below:

| | | | | | | | | | | | | |
|----|----|---|----|---|----|---|----|---|----|---|----|---|
| A | B | C | D | E | F | G | H | I | J | K | L | M |
| 1 | | | | | | | | | | | | |
| 2 | 6 | | 5 | | 4 | | 3 | | 2 | | 1 | |
| 3 | | | | | | | | | | | | |
| 4 | 7 | | 8 | | 9 | | 10 | | 11 | | 12 | |
| 5 | | | | | | | | | | | | |
| 6 | 18 | | 17 | | 16 | | 15 | | 14 | | 13 | |
| 7 | | | | | | | | | | | | |
| 8 | 19 | | 20 | | 21 | | 22 | | 23 | | 24 | |
| 9 | | | | | | | | | | | | |
| 10 | 30 | | 29 | | 28 | | 27 | | 26 | | 25 | |
| 11 | | | | | | | | | | | | |
| 12 | 31 | | 32 | | 33 | | 34 | | 35 | | 36 | |
| 13 | | | | | | | | | | | | |

NOTE: Not more than 2 corners, all in the same town and range, may be recorded on this certificate.

A. Description of original monument and accessories and/or subsequent restoration:

Original corner established by S.W. Higgins, U.S. Deputy Surveyor, Summer of 1846. Set wood post.

ORIGINAL BEARING TREES:

18" Hemlock N50°W 8.58 feet
 24" Hemlock S10°E 9.90 feet

FEELER GROUP APPROVED
Earl W. Applekamp
 COUNTY SURVEYOR
 5-13-98

B. Description of corner evidence found and/or method applied in restoring or reestablishing corner:


No original or other evidence was found. The area for at least a mile in all directions has been owned by one firm for 70-80 years. The entire area has recently been logged extensively and or clearcut. A control survey was run into the area to determine the theoretical location of the corner. This survey located corners 2 miles North and South and 1 mile East. Corner was re-established using this information and original survey calls to a river West and a major stream East. Corner was set in conformance with these calls and existing corners North, South and East.

Research on file with the Ontonagon County Remonumentation Program Representative.

C. Description of monument for corner and accessories established to perpetuate locating the position of the corner:

At the corner position I set a 2½"X30" split base aluminum pipe with a 3" cap stamped to read: County Remonumentation, T51N R42W, S23, S24, S25 and S26, 1998, P.S. 17610. I established 3 bearing trees and a reference object.

Nail in 7" Ash S81°W 28.81' - Nail in 6" Maple S18°E 24.00'
 Nail in 7" Maple N61°E 30.98' - 6" Steel Sign Post, North '0.80'

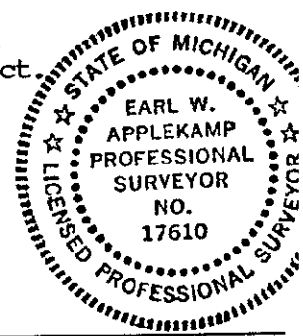

Signed by Earl W. Applekamp
 Surveyor's Michigan License No. 17610

Date April 24, 1998