

LAND CORNER RECORDATION CERTIFICATE
 Filing Requirement of Act 74, Mich. P.A. 1970

For corners in

<u>ONTONAGON</u> (County)	Located in:	Corner Code #
1. Public Land Survey	T51NR 42W	L-9
	T ___ R ___	_____
	T ___ R ___	_____
	T ___ R ___	_____
2. Property Controlling in Section	S ___ T ___ R ___	_____
	S ___ T ___ R ___	_____
3. Miscellaneous Property in Sec.	S ___ T ___ R ___	_____
	S ___ T ___ R ___	_____

JAN 11 1998

SECTION

Register of Deeds Stamp & File Number

4. Lot No. _____, Recorded Plat _____
 5. Private Claims _____

1/4 Corner common to Sections 24 & 25, T51N R42W.

I, Earl W. Applekamp, in a field survey on May 27, 1998 do hereby state that under requirements of P.A. 74, Michigan P.A. of 1970, the corner points mentioned in lines 1 and 2 above were in conformance with regulations and rules therefore as required in the current manual of survey instructions of the United States Department of the Interior, Bureau of Land Management or by a decree of a Court of Law and for that the corner points mentioned in lines 3, 4 and 5 above were in conformance with the rules of the Michigan Board of Land Surveyors or by a Decree of a Court of Law; established, re-established, monumented, recovered, found as expressed below:

A	B	C	D	E	F	G	H	I	J	K	L	M
1												
2	6	5	4	3	2	1						
3												
4	7	8	9	10	11	12						
5												
6	18	17	16	15	14	13						
7												
8	19	20	21	22	23	24						
9												
10	30	29	28	27	26	25						
11												
12	31	32	33	34	35	36						
13												

NOTE: Not more than 2 corners, all in the same town and range, may be recorded on this certificate.

A. Description of original monument and accessories and/or subsequent restoration:
 Original corner established by S.W. Higgins, U.S. Deputy Surveyor, Summer of 1846. Set Wood Post.

ORIGINAL BEARING TREES:

36" Hemlock	S67°W	18.48 feet
8" Ironwood	N70°E	5.94 feet


FREE GROUP APPROVAL
Earl W. Applekamp
 COUNTY REPRESENTATIVE
 6-17-98

B. Description of corner evidence found and/or method applied in restoring or reestablishing corner:
 No original evidence was found. Corner was re-established by single proportionate measure and on line between opposite Section Corners, East & West. This position is in conformance with original field note calls to the Big Iron River and a stream call.

Research on file with the Ontonagon County Remonumentation Program Representative.

C. Description of monument for corner and accessories established to perpetuate locating the position of the corner:
 At the corner position I set a 2 1/2"X30" split base aluminum pipe with a 3" cap stamped to read: County Remonumentation, T51N, R42W, 1/4, S24, S25, 1998, P.S. 17610. I established three bearing trees and a Steel Sign Post.

Nail in 8" S. Maple N84°W 42.25' - Nail in 10" S. Maple S35°E 20.10'
 Nail in 9" S. Maple N02°W 20.70' - 6' Steel Sign Post South 0.97'

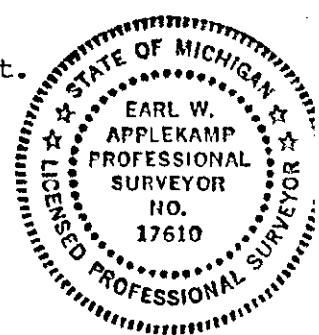

Signed by Earl W. Applekamp
 Surveyor's Michigan License No. 17610

Date June 2, 1998