

LAND CORNER RECORDATION CERTIFICATE
 Filing Requirement of Act 74, Mich. P.A. 1970

For corners in
ONTONAGON
 (County)

Located In: T51NR 42W Corner Code # L-11

1. Public Land Survey
 T ___ R ___
 T ___ R ___
 T ___ R ___

2. Property Controlling In Section
 S ___ T ___ R ___
 S ___ T ___ R ___

3. Miscellaneous Property In Sec.
 S ___ T ___ R ___
 S ___ T ___ R ___

REGISTERED
 JAN 11 1998
 SECTION
 Register of Deeds Stamp & File Number

4. Lot No. _____ Recorded Plat _____
 5. Private Claims _____

$\frac{1}{4}$ Corner common to Sections 25 & 36, T51N R42W.

I, Earl W. Applekamp, in a field survey on June 11, 1998 do hereby state that under requirements of P.A. 74, Michigan P.A. of 1970, the corner points mentioned in lines 1 and 2 above were in conformance with regulations and rules therefore as required in the current manual of survey instructions of the United States Department of the Interior, Bureau of Land Management or by a decree of a Court of Law and for that the corner points mentioned in lines 3, 4 and 5 above were in conformance with the rules of the Michigan Board of Land Surveyors or by a Decree of a Court of Law, established, re-established, monumented, recovered, found as expressed below.

NOTE: Not more than 2 corners, all in the same town and range, may be recorded on this certificate.

1	A	B	C	D	E	F	G	H	I	J	K	L	P
2		6		5		4		3		2		1	
3													
4		7		8		9		10		11		12	
5													
6		18		17		16		15		14		13	
7													
8		19		20		21		22		23		24	
9													
10		30		29		28		27		26		25	
11													
12		31		32		33		34		35		36	
13													

A. Description of original monument and accessories and/or subsequent restoration:

Original corner established by S.W. Higgins, U.S. Deputy Surveyor, summer of 1846. Set $\frac{1}{4}$ Corner which was 24" diameter Hemlock.

BEARING TREE:

12" White Birch N45°E 9.24 feet

B. Description of corner evidence found and/or method applied in restoring or reestablishing corner:

Near the calculated corner position I found a $1\frac{1}{2}$ "X30" steel shaft driven into an extremely decomposed remains of a large Hemlock stump. There was also a 6" square post laying on the ground. The position of the steel shaft was in conformance with the original field note calls. This corner falls on a steep hill 80' - 100' high near the Big Iron River. I re-established the corner at the steel shaft as being the location of the original corner placement.

Research on file with the Ontonagon County Remonumentation Program Representative.


C. Description of monument for corner and accessories established to perpetuate locating the position of the corner:

At the corner position I set a $2\frac{1}{2}$ "X30" split base aluminum pipe with a 3" cap stamped to read: County Remonumentation, T51N R42W, $\frac{1}{4}$, S25, S36, 1998, P.S. 17610. I established 3 bearing trees and a reference object.

Nail in 8" Spruce S86°W 17.78' - Nail in 8" Spruce S32°E 26.40
 Nail in 4" Hard Maple N33°W 21.36' - 6" Steel Sign Post East 1.10

PEER GROUP APPROVED

Earl W. Applekamp 6-17-98
 COUNTY REGISTER

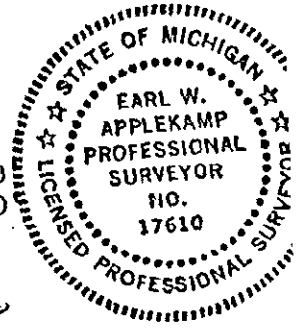

Signed by Earl W. Applekamp 17610
 Surveyor's Michigan License No. _____

Date June 12, 1998