

LAND CORNER RECORDATION CERTIFICATE
 Filing Requirement of Act 74, Mich. P.A. 1970

For corners in

<u>ONTONAGON</u> (County)	Located In:	Corner Code #
1. Public Land Survey	T51N R 41 T51N R 42W T ___ R ___ T ___ R ___	A-7 M-7
2. Property Controlling in Section	S ___ T ___ R ___ S ___ T ___ R ___	___
3. Miscellaneous Property in Sec.	S ___ T ___ R ___ S ___ T ___ R ___	___

SURVEY &
 REMONUMENTATION

JAN 11 1998

SECTION

Register of Deeds Stamp & File Number

4. Lot No. _____, Recorded Plat _____
 5. Private Claims _____

Section Corner common to Sections 18 & 19, T51N R41W
 & Sections 13 & 24, T51N R42W

I, Earl W. Applekamp, in a field survey on March 18, 1998 do hereby state that under requirements of P.A. 74, Michigan P.A. of 1970, the corner points mentioned in lines 1 and 2 above were in conformance with regulations and rules therefore as required in the current manual of survey instructions of the United States Department of the Interior, Bureau of Land Management or by a decree of a Court of Law and /or that the corner points mentioned in lines 3, 4 and 5 above were in conformance with the rules of the Michigan Board of Land Surveyors or by a Decree of a Court of Law; established, re-established, monumented, recovered, found as expressed below:

NOTE: Not more than 2 corners, all in the same town and range, may be recorded on this certificate.

A	B	C	D	E	F	G	H	I	J	K	L	M
1												
2	6	5	4	3	2	1						
3												
4	7	8	9	10	11	12						
5												
6	18	17	16	15	14	13						
7												
8	19	20	21	22	23	24						
9												
10	30	29	28	27	26	25						
11												
12	31	32	33	34	35	36						
13												

A. Description of original monument and accessories and/or subsequent restoration:

Original corner established by Austin Burt, U.S. Deputy Surveyor, Summer of 1845. Set Wood Post.

ORIGINAL BEARING TREES:

24" Hemlock S14°W 7.26 feet - 12" MAPLE N88°W 15.84 feet

Michigan Department of Transportation highway map produced in 1954 identifies the corner on the highway drawings and gives location with respect to the stationing and center-line, but did not monument.

B. Description of corner evidence found and/or method applied in restoring or reestablishing corner:

No original evidence was found. Area has been altered by an old road and subsequent highway construction in 1955. Corner was re-established by original GLO distances to corners North and South.


Research on file with the Ontonagon County Remonumentation Program Representative.

PEER GROUP APPROVED
Earl W. Applekamp
 COUNTY SURVEYOR
 5-13-98

C. Description of monument for corner and accessories established to perpetuate locating the position of the corner:

At the corner position I set a 2 1/2"X30" split base aluminum pipe with a 3" cap stamped to read: County Remonumentation, T51N, R41W, R42W, S13, S24, S18, S19, 1998, P.S. 17610. I witnessed the corner to several trees and other objects listed below. Corner is 38.8 feet East of Highway M-64.

- 4"X4" Conc. R.O.W. Post, S89°W, 78.9' - Nail in 11" Aspen, S18°E, 10.71'
- 4"X4" Conc. R.O.W. Post, N87°E, 35.7' - Nail in 10" Aspen, S76°W, 81.20'
- Nail in P. Pole, S84°E, 39.15 feet - Steel Sign Post East, 0.92 feet

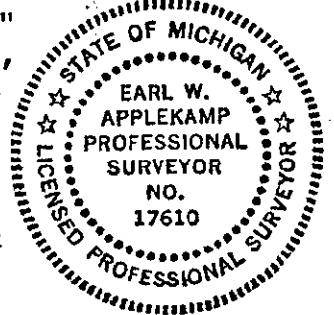

Signed by Earl W. Applekamp
 Surveyor's Michigan License No. 17610

Date March 24, 1998