

LAND CORNER RECORDATION CERTIFICATE
Filing Requirement of Act 74, Mich. P.A. 1970

For corners in

Table with columns: ONTONAGON (County), Located In:, Corner Code #. Includes entries for Public Land Survey, Property Controlling in Section, and Miscellaneous Property in Sec.

Register of Deeds Stamp & File Number. Includes text: SURVEY & REMONUMENTATION, JAN 11 1998, SECTION.

4. Lot No. , Recorded Plat
5. Private Claims

1/4 Corner common to Sections 25 & 30, T51N R41W & T51N R42W.

I, Earl W. Applekamp, in a field survey on March 25, 1998 do hereby state that under requirements of P.A. 74, Michigan P.A. of 1970, the corner points mentioned in lines 1 and 2 above were in conformance with regulations and rules therefore as required in the current manual of survey instructions of the United States Department of the Interior, Bureau of Land Management or by a decree of a Court of Law and /or that the corner points mentioned in lines 3, 4 and 5 above were in conformance with the rules of the Michigan Board of Land Surveyors or by a Decree of a Court of Law; established, re-established, monumented, recovered, found as expressed below:

NOTE: Not more than 2 corners, all in the same town and range, may be recorded on this certificate.

Grid table with columns A-M and rows 1-13. Contains numerical data for survey points.

A. Description of original monument and accessories and/or subsequent restoration:
Original corner established by Austin Burt, U.S. Deputy Surveyor, August 1845. Set Wood Post.

ORIGINAL BEARING TREES:
10" Hemlock S47°E 5.94 feet
12" Sugar N60°W 7.92 feet


B. Description of corner evidence found and/or method applied in restoring or reestablishing corner:
No original evidence was found. Corner position is in a large clear-cut area logged 3-4 years ago. Corner was re-established by single proportionate measure on line between opposite section corners North & South.

Research on file with the Ontonagon County Remonumentation Program Representative.

PEER GROUP APPROVED
Earl W. Applekamp
COUNTY REPRESENTATIVE
5-13-98

C. Description of monument for corner and accessories established to perpetuate locating the position of the corner:
At the corner position I set a 2 1/4" X 30" split base aluminum pipe with a 3" cap stamped to read: County Remonumentation, 1/4, T51N, R41W, R42W, S25, S30, 1998, P.S. 17610. I established three bearing trees and a reference object.

Nail in 3" Y. Birch N38°W 89.00' - Nail in 2" Y. Birch S50°W 20.92'
Nail in 2" Maple S68°E 30.05' - 6' Steel Sign Post, Due South 1.08'

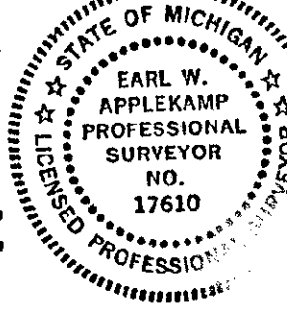

Signed by Earl W. Applekamp
Surveyor's Michigan License No. 17610

Date March 27, 1998