


Township 52 North

Range 39 West

2M 2-57 G.P.A.

001  
MC

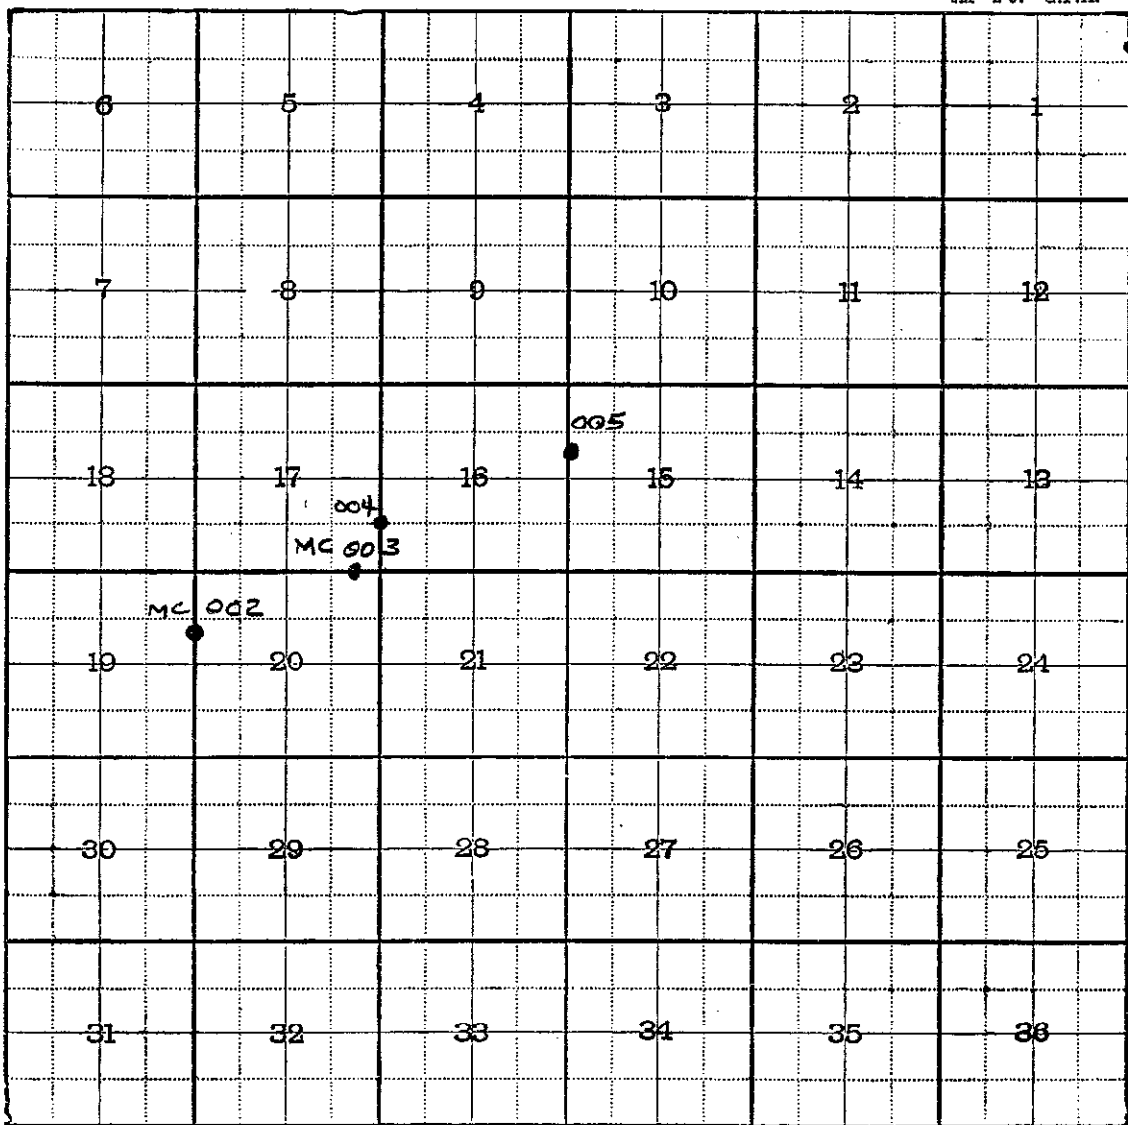

Ontonogon Co.