

SURVEY & REMONUMENTATION

JUDITH D. ROEHM
 Ontonagon County
 LC 4/137 JEM. Fee: 9.00
 07/12/96
 15:10
 Page 1 of 1

DEC 16 1996

LAND CORNER RECORDATION CERTIFICATE
 Filing Requirement of Act 74, Mich. P.A. 1970

For corners in COMMISSION
Ontonagon
 (County)

Located In:

Corner Code #

- | | | | | | | |
|---|---|------------|---|------------|------------|-------|
| 1. Public Land Survey | T | <u>52N</u> | R | <u>39W</u> | <u>B-9</u> | |
| | T | _____ | R | _____ | _____ | |
| | T | _____ | R | _____ | _____ | |
| | T | _____ | R | _____ | _____ | |
| 2. Property Controlling
In Section | S | _____ | T | _____ | R | _____ |
| | S | _____ | T | _____ | R | _____ |
| 3. Miscellaneous
Property in Section | S | _____ | T | _____ | R | _____ |
| | S | _____ | T | _____ | R | _____ |

Register of Deeds Stamp & File Number

4. Lot No. _____, Recorded Plat _____
 5. Private Claims _____

	A	B	C	D	E	F	G	H	I	J	K	L	M
2	6		5		4		3		2				
3													
4	7		6		5		4		3		2		1
5													
6	18		17		16		15		14		13		
7													
8	19		20		21		22		23		24		
9													
10	30		29		28		27		26		25		
11													
12	31		32		33		34		35		36		
13													

I, Joseph C. Domitrovich, in a field survey on June 21, 1996, do hereby certify that under requirements of P.A. 74, Michigan P.A. of 1970, the corner points mentioned in lines 1 and 2 above were in conformance with regulations and rules therefore as required in the current manual of survey instructions of the United States Department of the Interior, Bureau of Land Management or by a decree of a Court of Law and/or that the corner points mentioned in lines 3, 4 and 5 above were in conformance with the rules of the Michigan Board of Professional Surveyors or by a Decree of a Court of Law; established, re-established, monumented, re-monumented, recovered, found as expressed below:

NOTE: Not more than 4 corners, all in the same town and range, may be recorded on this certificate.

A. Description of original monument and accessories and/or subsequent restoration:

(B-9) 1/4 Corner common to Sections 19 and 30, T52N, R39W

1845 - William A. Burt, set fir post

- 12" Cedar N 48° E 25 links
- 24" Hemlock N 33° W 18 links

- John E. Erickson P.E. 2422, in the Assessor's Plats of the NE 1/4 of Section 30 and the E 1/2 of the SE 1/4 of the NW 1/4 of Section 30 shows this corner as being a concrete monument at the Southeast corner of R.O.W.'s of Paul Bunyan Ave. and 7th Street.
- The Beach Parkway Addition to the Village of Ontonagon shows corner as being at the Southeast corner of R.O.W.s.
- Robert Mick, P.S. 16936, shows corner as being a concrete monument in surveys.

B. Description of corner evidence found and/or method applied in restoring or reestablishing corner:

The original corner and accessories have been destroyed by Village street and utility construction. I found a 1/2" iron with cap no. 16936 set in the broken remains of a concrete monument. This fell at the southeast corner of R.O.W.s of Paul Bunyan Ave. and 7th Street. It worked very well with platted distances to south and east. I also found a nail and tag no. 19842 (William Riipi) in a Power pole northwest of the found iron. The iron works very well with other corners in the area.

I accepted the 1/2" iron as the 1/4 corner and have monumented it as such.

Research on file with County Remonumentation Representative.


C. Description of monument for corner and accessories established to perpetuate locating the position of the corner:

Corner is a 2" x 30" aluminum pipe with a 3" diameter aluminum cap stamped to read: 1/4 S.19, S.30; T.52N., R.39W.; 1996; P.S. 37273. Corner falls southeast of road intersection at the corner of a lawn.

Witnesses:

- T/N Fire Hydrant N 75° W 6.82'
- Power Pole N 30° W 70.33'
- 11" Soft Maple N 55° E 127.90'
- NW Foundation Corner S 18° E 33.85'
- 15" Soft Maple S 30° W 18.50'
- Steel Sign Post N 87° W 6.85'

PEER GROUP APPROVED
John W. Applekamp
 COUNTY REPRESENTATIVE
 07-08-96

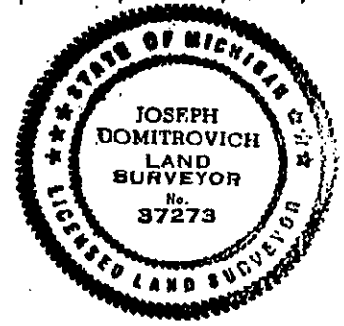

NOTE: Bearings are magnetic. Distances are to nail in side of witness objects unless noted.

Signed by Joseph C. Domitrovich

Date 7/8/96

Surveyor's Michigan License No. 37273