

**SURVEY & REMONUMENTATION**

APR 29 1996

JUDITH D. ROEHM  
 Ontonagon County  
 LC 3/ 338 JEM Fee: 9.00  
 Page 1 of 1


**COMMISSION LAND CORNER RECORDATION CERTIFICATE**  
 Filing Requirement of Act 74, Mich. P.A. 1970

For corners in Ontonagon (County) Located In: \_\_\_\_\_ Corner Code # \_\_\_\_\_

1. Public Land Survey	T <u>52N</u> R <u>39W</u>	<u>C-9</u>
	T _____ R _____	_____
	T _____ R _____	_____
	T _____ R _____	_____
2. Property Controlling in Section	S _____ T _____ R _____	_____
	S _____ T _____ R _____	_____
3. Miscellaneous Property in Section	S _____ T _____ R _____	_____
	S _____ T _____ R _____	_____

4. Lot No. \_\_\_\_\_, Recorded Plat \_\_\_\_\_  
 5. Private Claims \_\_\_\_\_

Register of Deeds Stamp & File Number

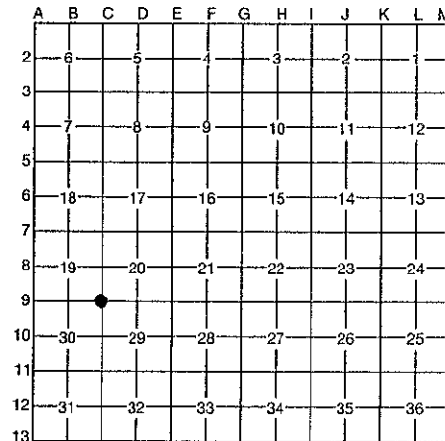

I, Joseph C. Domitrovich, in a field survey on October 13, 1995, do hereby certify that under requirements of P.A. 74, Michigan P.A. of 1970, the corner points mentioned in lines 1 and 2 above were in conformance with regulations and rules therefore as required in the current manual of survey instructions of the United States Department of the Interior, Bureau of Land Management or by a decree of a Court of Law and/or that the corner points mentioned in lines 3, 4 and 5 above were in conformance with the rules of the Michigan Board of Professional Surveyors or by a Decree of a Court of Law; established, re-established, monumented, re-monumented, recovered, found as expressed below:

**NOTE: Not more than 4 corners, all in the same town and range, may be recorded on this certificate.**

**A. Description of original monument and accessories and/or subsequent restoration:**

Corner of Sections 19, 20, 29 and 30, T52N, R39W

1845 -William A. Burt set sugar post  
 24" Hemlock S 15° E 50 links  
 16" Sugar N 63° W 5 links

1941 -John E. Erickson, P.E. 2422, Assessor's Plat of the Northeast 1/4, Section 30, shows this corner as the northeast corner of the plat.

**B. Description of corner evidence found and/or method applied in restoring or reestablishing corner:**

Found no evidence of original corner. Corner now falls in 3-way intersection.

Re-established corner position using found Monuments in the above noted plat. Distances within the plat work very well. Corner also works well with centerlines of roads east, west and south.

(Research on file with County Remonumentation Representative.)

**PEER GROUP APPROVED**  
*Paul W Applekamp* 10-18-95  
**COUNTY REPRESENTATIVE**

**C. Description of monument for corner and accessories established to perpetuate locating the position of the corner:**

Corner is a 5/8" x 24" rerod with 3" diameter stamped aluminum cap and falls 0.9' east of centerline Airport Road to south and falls 1.4' south of centerline Paul Bunyan Ave.

Witnesses:

Reference Monument (Aluminum pipe with stamped aluminum cap)	North	25.22'
Sign Post	North	26.12'
8" Soft Maple	S 29° E	57.20'
4" Square Concrete Plat Monument	S 45° W	46.81'
Power Pole #140	N 40° W	42.34'

**NOTE: Bearings are magnetic. Distances are to nail in side of witness objects unless noted.**

Signed by J. C. Domitrovich  
 Surveyor's Michigan License No. 37273

Date 10/18/95

