

SURVEY & REMONUMENTATION

APR 29 1996

COMMISSION

JUDITH D. ROEHM
 Ontonagon County
 LC 3/ 337 JEM Fee: 9.00
 10/19/95
 13:52
 Page 1 of 1

LAND CORNER RECORDATION CERTIFICATE
 Filing Requirement of Act 74, Mich. P.A. 1970

For corners in Ontonagon (County)	Located In:	Corner Code #
1. Public Land Survey	T <u>52N</u> R <u>39W</u>	C-10
	T _____ R _____	_____
	T _____ R _____	_____
	T _____ R _____	_____
2. Property Controlling in Section	S _____ T _____ R _____	_____
	S _____ T _____ R _____	_____
3. Miscellaneous Property in Section	S _____ T _____ R _____	_____
	S _____ T _____ R _____	_____

Register of Deeds Stamp & File Number

4. Lot No. _____, Recorded Plat _____
 5. Private Claims _____

	A	B	C	D	E	F	G	H	I	J	K	L	M
2	6		5		4		3		2		1		
3													
4	7		8		9		10		11		12		
5													
6	18		17		16		15		14		13		
7													
8	19		20		21		22		23		24		
9													
10	30		29		28		27		26		25		
11													
12	31		32		33		34		35		36		
13													

I, Joseph C. Domitrovich, in a field survey on October 17, 19 95, do hereby certify that under requirements of P.A. 74, Michigan P.A. of 1970, the corner points mentioned in lines 1 and 2 above were in conformance with regulations and rules therefore as required in the current manual of survey instructions of the United States Department of the Interior, Bureau of Land Management or by a decree of a Court of Law and/or that the corner points mentioned in lines 3, 4 and 5 above were in conformance with the rules of the Michigan Board of Professional Surveyors or by a Decree of a Court of Law; established, re-established, monumented, re-monumented, recovered, found as expressed below:

NOTE: Not more than 4 corners, all in the same town and range, may be recorded on this certificate.

A. Description of original monument and accessories and/or subsequent restoration:

1/4 Corner Sections 30 and 29, T52N, R39W

1845 -William A. Burt set Hemlock post
 10" Hemlock N 64° E 10 links
 8" Hemlock N 70° W 9 links

1941 -John E. Erickson, P.E. 2422, Assessor's Plat of NE 1/4 Section 30 shows 1/4 corner as southeast corner of plat.

1964 -Everett S. Thompson, P.E. 8606, Plat of Country Club Estates, shows 1/4 corner as northeast corner of plat and same bearing on east-west 1/4 line as shown in Assessor's Plat.

B. Description of corner evidence found and/or method applied in restoring or reestablishing corner:

Original corner and corner shown on both plats has been obliterated by road construction. Corner falls in 3-way intersection.

Re-established east-west position of corner on line between section corners and north-south position by pro-rating record distances from the two plats. Distances work very well with plats. Corner works well with road centerlines.

(Research on file with County Remonumentation Representative.)


C. Description of monument for corner and accessories established to perpetuate locating the position of the corner:

Corner is a 5/8" x 24" rerod with a 3" diameter stamped aluminum cap and falls at the intersection of centerlines, Michigan Ave. to west and Airport Road north and south.

Witnesses:

16" Jack Pine	N 17° E	94.96'		
Reference Monument (Aluminum pipe with 3" stamped aluminum cap)			East	26.61'
Sign Post	East	27.43'		
16" Jack Pine	S 35° E	47.10'		
Light Pole	N 54° W	46.25'		

PEER GROUP APPROVED
Paul W. Applekamp
 COUNTY REPRESENTATIVE

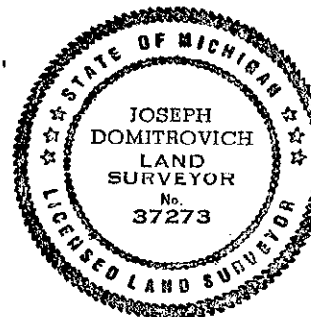

NOTE: Bearings are magnetic. Distances are to nail in side of witness objects unless noted.

Signed by J. C. Domitrovich

Date 10/18/95

Surveyor's Michigan License No. 37273