

SURVEY & REMONUMENTATION

APR 29 1995

COMMISSION

JUDITH D. ROEHR 10/19/95
 Ontonagon County 13:44
 LC 3/335 JEM Feet 9.00
 Page 1 of 1

LAND CORNER RECORDATION CERTIFICATE
Filing Requirement of Act 74, Mich. P.A. 1970


For corners in Ontonagon Located In: _____ Corner Code # _____
 (County)

1. Public Land Survey	T <u>52N</u> R <u>39W</u>	<u>C-12</u>
	T _____ R _____	_____
	T _____ R _____	_____
	T _____ R _____	_____
2. Property Controlling in Section	S _____ T _____ R _____	_____
	S _____ T _____ R _____	_____
3. Miscellaneous Property in Section	S _____ T _____ R _____	_____
	S _____ T _____ R _____	_____

4. Lot No. _____, Recorded Plat _____

5. Private Claims _____

Register of Deeds Stamp & File Number

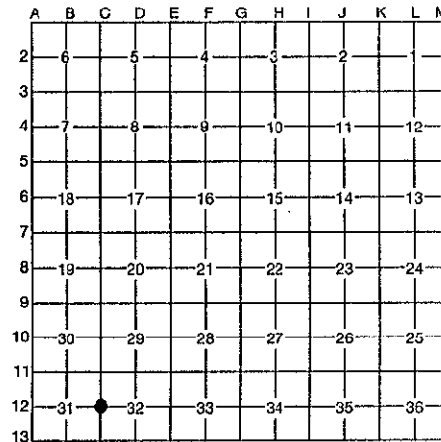

I, Joseph C. Domitrovich, in a field survey on September 29, 1995, do hereby certify that under requirements of P.A. 74, Michigan P.A. of 1970, the corner points mentioned in lines 1 and 2 above were in conformance with regulations and rules therefore as required in the current manual of survey instructions of the United States Department of the Interior, Bureau of Land Management or by a decree of a Court of Law and/or that the corner points mentioned in lines 3, 4 and 5 above were in conformance with the rules of the Michigan Board of Professional Surveyors or by a Decree of a Court of Law; established, re-established, monumented, re-monumented, recovered, found as expressed below:

NOTE: Not more than 4 corners, all in the same town and range, may be recorded on this certificate.

A. Description of original monument and accessories and/or subsequent restoration:

(C-12) 1/4 corner sections 31 and 32 T52N, R39W

- 1845 - William A. Burt set sugar post
 10" Hemlock N 67° E 29 links
 12" Maple N 70° W 7 links
- 1966 - C. C. Lindgren P. S. 14098, M.S.H.D. for M-38 Highway construction plans. Found corner and established 3 new bearing objects.
- 1997 - Dennis Destramp P.S. 18983 in survey for village of Ontonagon, added 3 new bearing trees.

B. Description of corner evidence found and/or method applied in restoring or reestablishing corner:

Found a 1" iron pin 12" below ground, 2 remaining M.S.H.D. witnesses, and 3 Destramp witnesses. The iron matches closely the angle and distance off of centerline M-38 as noted on Highway plans. The iron appears to have been re-established by single proportionate measurement. Accepted corner position as monumented and replaced with a county monument.

(Research on file with County Remonumentation Representative.)


PEER GROUP APPROVED
Earl W. Applebury 10-18-95
COUNTY REPRESENTATIVE

C. Description of monument for corner and accessories established to perpetuate locating the position of the corner:

Corner is an Aluminum pipe with a 3" diameter stamped cap and falls in a Red Pine woods.

Witnesses:

12" Red Pine	N 04° E	17.60'	(Nail & 18983 tag)
12" Balsam	S 56° E	22.56'	(Grown over M.S.H.D. Nail & 18983 tag.)
Cedar Fence Post	S 26° E	5.50'	(Nail & M.S.H.D. tag.)
12" Soft Maple	S 10° E	39.88'	(Nail & 18983 tag.)
10" Red Pine	N 73° W	25.99'	(Nail & 18983 tag.)

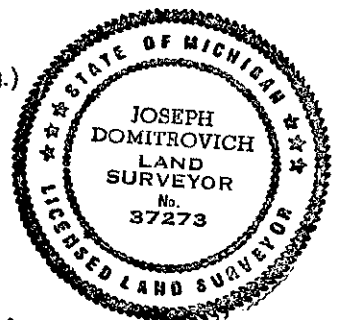

NOTE: Bearings are magnetic. Distances are to nail in side of witness objects unless noted.

Signed by J.C. Domitrovich Date 10/10/95
 Surveyor's Michigan License No. 37273