

SURVEY & REMONUMENTATION

APR 29 1996

JUDITH D. ROEHM 11/07/95
 Ontonagon County 10:21
 LC 3/402 JEM Fee: 9.00
 Page 1 of 1

COMMISSION

LAND CORNER RECORDATION CERTIFICATE
 Filing Requirement of Act 74, Mich. P.A. 1970

For corners in Ontonagon Located In: _____ Corner Code # _____
 (County)

- | | | | | | |
|--------------------------------------|---|-------|---|-------|-------|
| 1. Public Land Survey | T | 52N | R | 39W | C-13 |
| | T | _____ | R | _____ | _____ |
| | T | _____ | R | _____ | _____ |
| | T | _____ | R | _____ | _____ |
| 2. Property Controlling in Section | S | _____ | T | _____ | R |
| | S | _____ | T | _____ | R |
| 3. Miscellaneous Property in Section | S | _____ | T | _____ | R |
| | S | _____ | T | _____ | R |

Register of Deeds Stamp & File Number

4. Lot No. _____, Recorded Plat _____
 5. Private Claims _____

A	B	C	D	E	F	G	H	I	J	K	L	M
2	6	5	4	3	2	1						
3												
4	7	8	9	10	11	12						
5												
6	18	17	16	15	14	13						
7												
8	19	20	21	22	23	24						
9												
10	30	29	28	27	26	25						
11												
12	31	32	33	34	35	36						
13												

I, Joseph C. Domitrovich, in a field survey on October 25, 19 95, do hereby certify that under requirements of P.A. 74, Michigan P.A. of 1970, the corner points mentioned in lines 1 and 2 above were in conformance with regulations and rules therefore as required in the current manual of survey instructions of the United States Department of the Interior, Bureau of Land Management or by a decree of a Court of Law and/or that the corner points mentioned in lines 3, 4 and 5 above were in conformance with the rules of the Michigan Board of Professional Surveyors or by a Decree of a Court of Law; established, re-established, monumented, re-monumented, recovered, found as expressed below:

NOTE: Not more than 4 corners, all in the same town and range, may be recorded on this certificate.

A. Description of original monument and accessories and/or subsequent restoration:

Standard Section Corner Sections 31 & 32, T52N, R39W

1845- William A. Burt set Hemlock post, 12" Hemlock N41°E 17 Links
 14" Y. Birch N68°W 35 Links

1966- C.C. Lindgen, P.S. 14098, for M.S.H.D. M-38 Highway plans found a 1" iron pipe and called it common with section corner to South. He established 3 new bearing trees.

1983- Robert Mick P.S. 16936, in survey recorded on page 59 of survey records shows corner as common and 3 bearing trees matching Lindgren's bearings and distances. He did not indicate what the corner was.

1990- Dennis Destramp P.S. 18983 re-witnessed corner.

1995- Earl Applekamp P.S. 17610 re-established closing corner to the east.

B. Description of corner evidence found and/or method applied in restoring or reestablishing corner:

Found a 3/4" pipe and a 1/2" iron driven into a 1" pipe. Found one remaining Lindgren bearing tree which matched his bearing and distance to pipe. Found 3 Destramp bearing trees (one was the same as Lindgren's) facing the found pipe. Also found Earl Applekamp closing corner in centerline of Cherry Lane 32.96' to east. Also found Applekamp witness monument 32.80' east of closing corner.

The found pipe works very well with corners to the north. Accepted position of pipe as the Standard Section Corner and replaced with a county monument.

PEER GROUP APPROVED

Earl Applekamp
 COUNTY REPRESENTATIVE
 11-06-95


Research on file with County Remonumentation representative.

C. Description of monument for corner and accessories established to perpetuate locating the position of the corner:

Corner is an aluminum pipe with a 3" diameter stamped aluminum cap and falls 33' west of centerline Cherry Lane.

Witnesses:

Closing Corner, Sections 5 & 6, T51N R39W (stamped aluminum cap)	East 32.96'
Reference Monument to closing corner (aluminum pipe with stamped aluminum cap)	East 65.76'
8" White Pine S77°E 73.20' (P.S. 18983 nail and tag)	
8" Apple S 20°W 46.72' (M.S.H.D. & P.S. 18983)	
Steel Sign Post West 0.69'	
8" Oak N48°W 94.80' (P.S. 18983 nail and tag)	

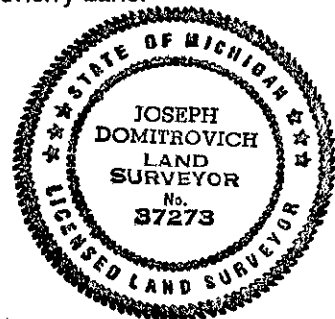

NOTE: Bearings are magnetic. Distances are to nail in side of witness objects unless noted.

Signed by J. C. Domitrovich Date 11/5/95

Surveyor's Michigan License No. 37273