

SURVEY & REMONUMENTATION

APR 29 1996

COMMISSION


LAND CORNER RECORDATION CERTIFICATE
Filing Requirement of Act 74, Mich. P.A. 1970

JUDITH D. ROEHM
 Ontonagon County
 LC 3/333 JEM Fee: 9.00
 Page 1 of 1

For corners in <u>Ontonagon</u> (County)	Located In:	Corner Code #
1. Public Land Survey	T <u>52N</u> R <u>39W</u>	D-11
	T _____ R _____	_____
	T _____ R _____	_____
	T _____ R _____	_____
2. Property Controlling in Section	S _____ T _____ R _____	_____
	S _____ T _____ R _____	_____
3. Miscellaneous Property in Section	S _____ T _____ R _____	_____
	S _____ T _____ R _____	_____

Register of Deeds Stamp & File Number

4. Lot No. _____, Recorded Plat _____
 5. Private Claims _____

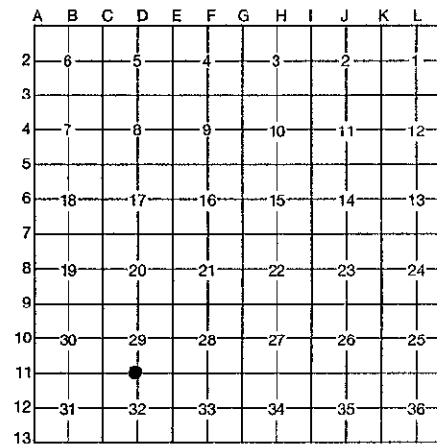

I, Joseph C. Domitrovich, in a field survey on October 17, 19 95, do hereby certify that under requirements of P.A. 74, Michigan P.A. of 1970, the corner points mentioned in lines 1 and 2 above were in conformance with regulations and rules therefore as required in the current manual of survey instructions of the United States Department of the Interior, Bureau of Land Management or by a decree of a Court of Law and/or that the corner points mentioned in lines 3, 4 and 5 above were in conformance with the rules of the Michigan Board of Professional Surveyors or by a Decree of a Court of Law; established, re-established, monumented, re-monumented, recovered, found as expressed below:

NOTE: Not more than 4 corners, all in the same town and range, may be recorded on this certificate.

A. Description of original monument and accessories and/or subsequent restoration:

1/4 Corner Section 29 and 32 T52N, R39W

1845 -William A. Burt set B. Ash post
 8" Cedar N 37° E 16 links
 6" Fir N 36° W 32 links

B. Description of corner evidence found and/or method applied in restoring or reestablishing corner:

Found no remains of original corner. Area has been extensively farmed. The long accepted and occupied 1/4 corner position appears to be the corner of old fences running east, west, and north. This position works well with section corners to east and west.

Accepted fence corner as 1/4 corner position and replaced with a county monument.

(Research on file with County Remonumentation Representative.)


C. Description of monument for corner and accessories established to perpetuate locating the position of the corner:

Corner is an aluminum pipe with a 3" diameter stamped aluminum pipe and falls at the corner of fences north, west and east. Another north-south fenceline falls 60" to the west. Also a newer electric fence falls 4' to south.

Witnesses:

15" Soft Maple	N 02° W	19.75'
7" Basswood	N 64° E	1.89'
4" Hard Maple	S 43° E	7.78'
Sign Post	South	0.78'
7" Ash	N 70° W	4.05'

PEER GROUP APPROVED
Paul W. Applekamp 10-18-95
COUNTY REPRESENTATIVE

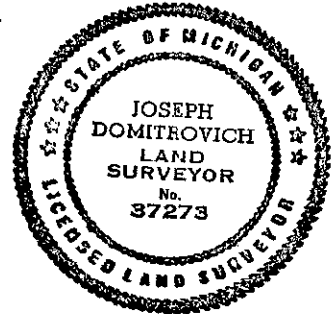

NOTE: Bearings are magnetic. Distances are to nail in side of witness objects unless noted.

Signed by J. C. Domitrovich Date 10/18/95

Surveyor's Michigan License No. 37273