

APR 29 1996

**COMMISSION**

JUDITH D. ROEHM  
 Ontonagon County  
 LC 3/341 JEM Fee: 9.00  
 10/19/95  
 14:12  
 Page 1 of 1

**LAND CORNER RECORDATION CERTIFICATE**  
**Filing Requirement of Act 74, Mich. P.A. 1970**

For corners in Ontonagon (County) Located In: \_\_\_\_\_ Corner Code # \_\_\_\_\_

1. Public Land Survey	T	<u>52N</u>	R	<u>39W</u>	<u>E-7</u>
	T	_____	R	_____	_____
	T	_____	R	_____	_____
	T	_____	R	_____	_____
2. Property Controlling in Section	S	_____	T	_____	R
	S	_____	T	_____	R
3. Miscellaneous Property in Section	S	_____	T	_____	R
	S	_____	T	_____	R

4. Lot No. \_\_\_\_\_, Recorded Plat \_\_\_\_\_

5. Private Claims \_\_\_\_\_

Register of Deeds Stamp & File Number

A	B	C	D	E	F	G	H	I	J	K	L
2	6	5	4	3	2	1					
3											
4	7	8	9	10	11	12					
5											
6	18	17	16	15	14	13					
7											
8	19	20	21	22	23	24					
9											
10	30	29	28	27	26	25					
11											
12	31	32	33	34	35	36					
13											

I, Joseph C. Domitrovich, in a field survey on October 2, 19 95, do hereby certify that under requirements of P.A. 74, Michigan P.A. of 1970, the corner points mentioned in lines 1 and 2 above were in conformance with regulations and rules therefore as required in the current manual of survey instructions of the United States Department of the Interior, Bureau of Land Management or by a decree of a Court of Law and/or that the corner points mentioned in lines 3, 4 and 5 above were in conformance with the rules of the Michigan Board of Professional Surveyors or by a Decree of a Court of Law; established, re-established, monumented, re-monumented, recovered, found as expressed below:

**NOTE: Not more than 4 corners, all in the same town and range, may be recorded on this certificate.**

**A. Description of original monument and accessories and/or subsequent restoration:**

Corner of Sections 16, 17, 20 and 21, T52N, R39W

1845 - William A. Burt set a Maple post

18" Maple S 08° E 21 links

14" White Pine N 50° W 4 links

1920 - E. J. Donnelly, C. E. noted on P. 44 of original notes at Ontonagon County Courthouse that a bearing tree was still standing at this corner.

1971 - Robert A. Mick P. S. 16936, in Turner's Lakeview Plat No. 2, shows section corner but does not note what it is.

1992 - Dennis Destramp P.S. 18983 in Survey recorded in Liber 1, Page 134 of surveys shows corner as a 1/2" pipe and added 4 new bearing trees.

**B. Description of corner evidence found and/or method applied in restoring or reestablishing corner:**

Found a 3/4" pinched top pipe which worked very well with remaining monuments in Turner's Lakeview Plat No. 2, and matched bearings and distances to Destramp bearing trees.

Found rotten remains of a large White Pine stump at N 50° W 2.5' which matches original bearing tree. Corner also works well with other corners in area.

Accepted Corner position and replaced with a County Monument.

PEER GROUP APPROVED

*Earl W. Destramp* 10-18-95  
 COUNTY REPRESENTATIVE


(Research on file with County Remonumentation Representative.)

**C. Description of monument for corner and accessories established to perpetuate locating the position of the corner:**

Corner is an aluminum pipe with a 3" stamped aluminum cap, and falls on an extension of a brushed line to the east.

**Witnesses:**

10" White Birch	N 16° E	5.34'	(Existing)
10" White Birch	N 68° E	11.61'	(Existing)
10" Poplar	S 50° E	7.26'	(Existing)
6" White Birch	S 38° W	4.45'	(Existing)
Sign Post	West	1.03'	

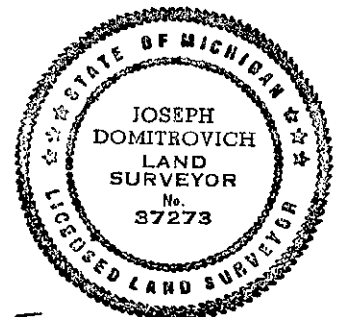

**NOTE:** Bearings are magnetic. Distances are to nail in side of witness objects unless noted.

Signed by J. C. Domitrovich

Date 10/10/95

Surveyor's Michigan License No. 37273