

SURVEY & REMONUMENTATION

APR 29 1996

COMMISSION

JUDITH D. ROEHM
 Ontonagon County
 LC 3/ 354 JEM Feet: 9.00
 10/19/95
 15:05
 Page 1 of 1

LAND CORNER RECORDATION CERTIFICATE
 Filing Requirement of Act 74, Mich. P.A. 1970

For corners in Ontonagon (County) Located In: _____ Corner Code # _____

1. Public Land Survey	T	<u>52N</u>	R	<u>39W</u>	<u>E-8</u>
	T	_____	R	_____	_____
	T	_____	R	_____	_____
	T	_____	R	_____	_____
2. Property Controlling in Section	S	_____	T	_____	R
	S	_____	T	_____	R
3. Miscellaneous Property in Section	S	_____	T	_____	R
	S	_____	T	_____	R

4. Lot No. _____, Recorded Plat _____
 5. Private Claims _____

Register of Deeds Stamp & File Number

A	B	C	D	E	F	G	H	I	J	K	L	M
2	6	5	4	3	2	1						
3												
4	7	8	9	10	11	12						
5												
6	18	17	16	15	14	13						
7												
8	19	20	21	22	23	24						
9												
10	30	29	28	27	26	25						
11												
12	31	32	33	34	35	36						
13												

I, Joseph C. Domitrovich, in a field survey on October 12, 1995, do hereby certify that under requirements of P.A. 74, Michigan P.A. of 1970, the corner points mentioned in lines 1 and 2 above were in conformance with regulations and rules therefore as required in the current manual of survey instructions of the United States Department of the Interior, Bureau of Land Management or by a decree of a Court of Law and/or that the corner points mentioned in lines 3, 4 and 5 above were in conformance with the rules of the Michigan Board of Professional Surveyors or by a Decree of a Court of Law; established, re-established, monumented, re-monumented, recovered, found as expressed below:

NOTE: Not more than 4 corners, all in the same town and range, may be recorded on this certificate.

A. Description of original monument and accessories and/or subsequent restoration:

1/4 Corner of Sections 20 and 21, T52N, R39W

1845 -William A. Burt set Cedar post
 6" Fir S 61° E 19 links
 6" Cedar S 10° W 6 links

B. Description of corner evidence found and/or method applied in restoring or reestablishing corner:

Found a 1" pipe in the west ditch of north-south gravel road which the current property owner, Mrs. Trudgeon, stated was set by the county years ago. She was told this by the person who sold her the property, who was present at the time the pipe was set.

The corner appears to be a R.O.W. corner and actual corner was probably taken out when the road was lifted. Held the pipe for a north-south position and put corner on line with section corners to north and south.

A found nail in a power pole works well with this position as do other corners in area.

(Research on file with County Remonumentation Representative.)


C. Description of monument for corner and accessories established to perpetuate locating the position of the corner:

Corner is a 5/8" x 24" rerod with 3" diameter stamped aluminum cap and falls 10' east of centerline north-south gravel road.

Witnesses:

Power Pole	N 42° E	26.41'	(found nail)		
Reference Monument (Aluminum pipe with stamped aluminum cap)			East	13.12'	
Sign Post	East	13.84'			
32" Poplar	S 70° E	30.92'			
6" Ash	S 70° W	38.28'			
Found 1" pipe	West	32.20'			

PEER GROUP APPROVED
Earl W. Applekamp
 COUNTY REPRESENTATIVE 10-18-95

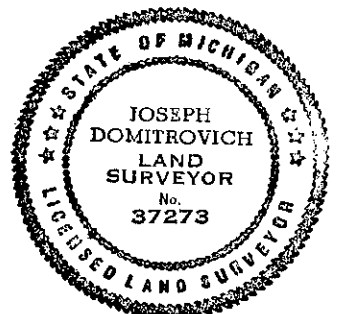

NOTE: Bearings are magnetic. Distances are to nail in side of witness objects unless noted.

Signed by J. C. Domitrovich

Date 10/10/95

Surveyor's Michigan License No. 37273