

SURVEY & REMONUMENTATION

APR 29 1995

COMMISSION

LAND CORNER RECORDATION CERTIFICATE
Filing Requirement of Act 74, Mich. P.A. 1970

JUDITH D. ROEHM
 Ontonagon County
 3/ 356 JEM Fee: 9.00
 Page 1 of 1

For corners in Ontonagon Located In: _____ Corner Code # _____
 (County)

- | | | | | | |
|--------------------------------------|---|------------|---|------------|-------------|
| 1. Public Land Survey | T | <u>52N</u> | R | <u>39W</u> | <u>E-10</u> |
| | T | _____ | R | _____ | _____ |
| | T | _____ | R | _____ | _____ |
| | T | _____ | R | _____ | _____ |
| 2. Property Controlling in Section | S | _____ | T | _____ | R |
| | S | _____ | T | _____ | R |
| 3. Miscellaneous Property in Section | S | _____ | T | _____ | R |
| | S | _____ | T | _____ | R |

Register of Deeds Stamp & File Number

4. Lot No. _____, Recorded Plat _____
 5. Private Claims _____

A	B	C	D	E	F	G	H	I	J	K	L	M
2	6	5	4	3	2	1						
3												
4	7	8	9	10	11	12						
5												
6	18	17	16	15	14	13						
7												
8	19	20	21	22	23	24						
9												
10	30	29	28	27	26	25						
11												
12	31	32	33	34	35	36						
13												

I, Joseph C. Domitrovich, in a field survey on October 17, 19 95, do hereby certify that under requirements of P.A. 74, Michigan P.A. of 1970, the corner points mentioned in lines 1 and 2 above were in conformance with regulations and rules therefore as required in the current manual of survey instructions of the United States Department of the Interior, Bureau of Land Management or by a decree of a Court of Law and/or that the corner points mentioned in lines 3, 4 and 5 above were in conformance with the rules of the Michigan Board of Professional Surveyors or by a Decree of a Court of Law; established, re-established, monumented, re-monumented, recovered, found as expressed below:

NOTE: Not more than 4 corners, all in the same town and range, may be recorded on this certificate.

A. Description of original monument and accessories and/or subsequent restoration:

1/4 Corner Sections 29, and 28, T52N, R39W

1845 -William A. Burt set Fir post
 16" Hemlock N 34° E 26 links
 9" Y. Birch N 24° W 18 links

B. Description of corner evidence found and/or method applied in restoring or reestablishing corner:

Found no remains of original corner. An east-west fenceline has been the long accepted and occupied 1/4 line. I re-established the corner position holding the east-west fenceline for north-south position and on line between section corners for the east-west position. Corner work well with centerline of north-south road.

(Research on file with County Remonumentation Representative.)

C. Description of monument for corner and accessories established to perpetuate locating the position of the corner:


Corner is a 5/8" x 24" rerod with a 3" diameter stamped aluminum cap and falls 2.7' west of centerline north-south Strang Road. Fencelines run east and west of corner.

Witnesses:

10" Spruce	N 23° E	77.77'
Power Pole	S 85° E	28.33'
6" Ash	S 45° W	38.74'
Reference monument (Aluminum pipe with stamped aluminum cap)	West	25.02'
Sign Post	West	25.61'
Anchor Pole	S 80° W	21.80'

PEER GROUP APPROVED

Carl W. Applbaum
 COUNTY REPRESENTATIVE 10-18-95

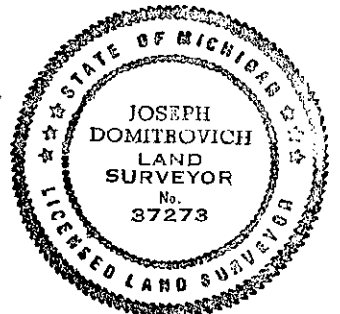

NOTE: Bearings are magnetic. Distances are to nail in side of witness objects unless noted.

Signed by J. C. Domitrovich Date 10/18/95

Surveyor's Michigan License No. 37273

FORM APPROVED BY MICHIGAN STATE BOARD OF PROFESSIONAL SURVEYORS, JAN. 28, 1971
 REVISED MAY 14, 1975
 REVISED JAN., 1983