

SURVEY & REMONUMENTATION

APR 29 1996

COMMISSION

JUDITH D. ROEHM
Ontonagon County
LC 3/ 357 JEM Fee: 9.00
10/19/95
15:14
Page 1 of 1

LAND CORNER RECORDATION CERTIFICATE
Filing Requirement of Act 74, Mich. P.A. 1970

For corners in <u>Ontonagon</u> <small>(County)</small>	Located In:	Corner Code #
1. Public Land Survey	T <u>52N</u> R <u>39W</u>	<u>E-11</u>
	T _____ R _____	_____
	T _____ R _____	_____
	T _____ R _____	_____
2. Property Controlling in Section	S _____ T _____ R _____	_____
	S _____ T _____ R _____	_____
3. Miscellaneous Property in Section	S _____ T _____ R _____	_____
	S _____ T _____ R _____	_____

Register of Deeds Stamp & File Number

4. Lot No. _____, Recorded Plat _____
5. Private Claims _____

A	B	C	D	E	F	G	H	I	J	K	L	M
2	6	5	4	3	2	1						
3												
4	7	8	9	10	11	12						
5												
6	18	17	16	15	14	13						
7												
8	19	20	21	22	23	24						
9												
10	30	29	28	27	26	25						
11												
12	31	32	33	34	35	36						
13												

I, Joseph C. Domitrovich, in a field survey on October 16, 19 95, do hereby certify that under requirements of P.A. 74, Michigan P.A. of 1970, the corner points mentioned in lines 1 and 2 above were in conformance with regulations and rules therefore as required in the current manual of survey instructions of the United States Department of the Interior, Bureau of Land Management or by a decree of a Court of Law and/or that the corner points mentioned in lines 3, 4 and 5 above were in conformance with the rules of the Michigan Board of Professional Surveyors or by a Decree of a Court of Law; established, re-established, monumented, re-monumented, recovered, found as expressed below:

NOTE: Not more than 4 corners, all in the same town and range, may be recorded on this certificate.

A. Description of original monument and accessories and/or subsequent restoration:

Corner of Sections 28, 29, 32 and 33, T52N, R39W

1845 -William A. Burt set Fir post
12" Hemlock S 47° W 26 links
16" Y. Birch N 32° E 39 links

B. Description of corner evidence found and/or method applied in restoring or reestablishing corner:

No evidence remains of original corner due to road construction and farming. Corner now falls in a 4-way intersection. A road runs north, east, south and northwest from this intersection. Held the intersection of centerlines of roads north and south and road to east as the long occupied and accepted corner position. This position works well with other corners in area.

(Research on file with County Remonumentation Representative.)

C. Description of monument for corner and accessories established to perpetuate locating the position of the corner:


Corner is a 5/8" x 24" rerod with 3" diameter stamped aluminum cap and falls at the intersection of centerlines of a 4-way intersection as noted above.

Witnesses:

Power Pole w/meter	N 44° E	46.79'
Anchor Pole	S 25° E	46.88'
Twin 6" Maple	S 54° W	56.98'
Reference Monument (Aluminum pipe with stamped aluminum cap)	West	49.60'
Sign Post	West	50.43'

PEER GROUP APPROVED

Earl W. Applebaum
COUNTY REPRESENTATIVE 10-18-95

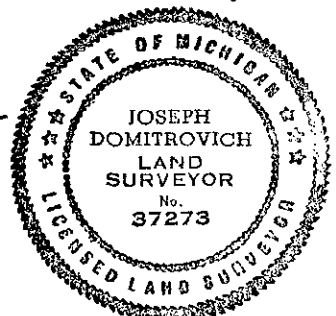

NOTE: Bearings are magnetic. Distances are to nail in side of witness objects unless noted.

Signed by Joseph C. Domitrovich Date 10/18/95

Surveyor's Michigan License No. 37273

FORM APPROVED BY MICHIGAN STATE BOARD OF PROFESSIONAL SURVEYORS, JAN. 28, 1971
REVISED MAY 14, 1975
REVISED JAN, 1983