

SURVEY & REMONUMENTATION

APR 29 1996

JUDITH D. ROEHM
 Ontonagon County
 LC 3/360 JEM Fee: 9.00
 10/19/95
 15:22
 Page 1 of 1

LAND CORNER RECORDATION CERTIFICATE
 Filing Requirement of Act 74, Mich. P.A. 1970

For corners in
Ontonagon
 (County)


Located In: _____ Corner Code # _____

- | | | | | | | |
|--------------------------------------|---|------------|---|------------|------------|-------|
| 1. Public Land Survey | T | <u>52N</u> | R | <u>39W</u> | <u>F-7</u> | |
| | T | _____ | R | _____ | _____ | |
| | T | _____ | R | _____ | _____ | |
| | T | _____ | R | _____ | _____ | |
| 2. Property Controlling in Section | S | _____ | T | _____ | R | _____ |
| | S | _____ | T | _____ | R | _____ |
| 3. Miscellaneous Property in Section | S | _____ | T | _____ | R | _____ |
| | S | _____ | T | _____ | R | _____ |

Register of Deeds Stamp & File Number

4. Lot No. _____, Recorded Plat _____
 5. Private Claims _____

I, Joseph C. Domitrovich, in a field survey on October 12, 1995, do hereby certify that under requirements of P.A. 74, Michigan P.A. of 1970, the corner points mentioned in lines 1 and 2 above were in conformance with regulations and rules therefore as required in the current manual of survey instructions of the United States Department of the Interior, Bureau of Land Management or by a decree of a Court of Law and/or that the corner points mentioned in lines 3, 4 and 5 above were in conformance with the rules of the Michigan Board of Professional Surveyors or by a Decree of a Court of Law; established, re-established, monumented, re-monumented, recovered, found as expressed below:

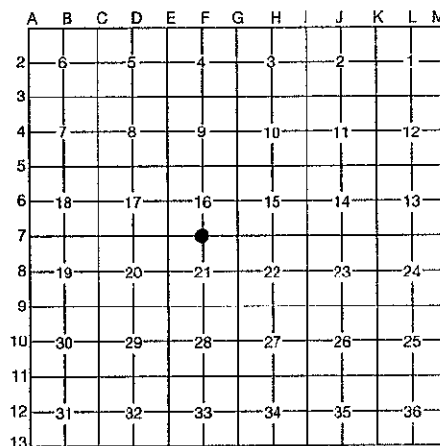

NOTE: Not more than 4 corners, all in the same town and range, may be recorded on this certificate.

A. Description of original monument and accessories and/or subsequent restoration:

1/4 Corner, Sections 16 and 21, T52N, R39W

1845 -William A Burt set 1/4 section post

- 14" Hemlock N 48° E 25 links
- 12" Sugar N 38° W 32 links

1992 -Dennis Destramp, P.S. 18983, in survey recorded in Liber 1, p.134 of surveys, found a R.R. spike in south lane of Lakeshore Road and noted four bearing objects.

1993 -Earl Applecamp, P.S. 17610 references corner in numerous surveys in section 16 but does not indicate what it is.

B. Description of corner evidence found and/or method applied in restoring or reestablishing corner:

Found no evidence of original corner.

Found a railroad spike 2" below paved surface in south lane of Lakeshore road. Found 3 remaining Destramp bearing objects which matched his distances to the found corner.

Corner appears to have been re-established on line between section corners and on the extension of Putula Road to the south.

Corner works well with others in area. Accepted corner position and replaced with a county monument.

PEER GROUP APPROVED
Earl W Applecamp 10-18-95
COUNTY REPRESENTATIVE

(Research on file with County Remonumentation Representative.)

C. Description of monument for corner and accessories established to perpetuate locating the position of the corner:

Corner is a 5/8" rerod with a 3" diameter stamped aluminum cap and falls 4.5' south of centerline Lakeshore Road, and on centerline of Putula Road to the south.

Witnesses:

- | | | | |
|--|---------|--------|-----------------------------|
| 8" Maple | N 34° E | 67.94' | (Destramp - nail) |
| Corner Fencepost | S 50° E | 44.62' | (Destramp - added new nail) |
| Bench Mark (Stamped Brass tablet in concrete) | S 23° W | 63.66' | (Destramp) |
| Reference Monument (Aluminum pipe with stamped aluminum cap) | North | 34.13' | |



NOTE: Bearings are magnetic. Distances are to nail in side of witness objects unless noted.

Signed by J. C. Domitrovich

Date 10/10/95

Surveyor's Michigan License No. 37273