

SURVEY & REMONUMENTATION

APR 29 1996

JUDITH D. ROEHM
 Ontonagon County
 LC 3/361 JEM Feet 9.00
 Page 1 of 1

COMMISSION

LAND CORNER RECORDATION CERTIFICATE

Filing Requirement of Act 74, Mich. P.A. 1970


For corners in Ontonagon Located In: _____ Corner Code # _____
 (County)

1. Public Land Survey	T	<u>52N</u>	R	<u>39W</u>	<u>F-9</u>
	T	_____	R	_____	_____
	T	_____	R	_____	_____
	T	_____	R	_____	_____
2. Property Controlling in Section	S	_____	T	_____	R
	S	_____	T	_____	R
3. Miscellaneous Property in Section	S	_____	T	_____	R
	S	_____	T	_____	R

Register of Deeds Stamp & File Number

4. Lot No. _____, Recorded Plat _____
 5. Private Claims _____

I, Joseph C. Domitrovich, in a field survey on October 12, 1995, do hereby certify that under requirements of P.A. 74, Michigan P.A. of 1970, the corner points mentioned in lines 1 and 2 above were in conformance with regulations and rules therefore as required in the current manual of survey instructions of the United States Department of the Interior, Bureau of Land Management or by a decree of a Court of Law and/or that the corner points mentioned in lines 3, 4 and 5 above were in conformance with the rules of the Michigan Board of Professional Surveyors or by a Decree of a Court of Law; established, re-established, monumented, re-monumented, recovered, found as expressed below:

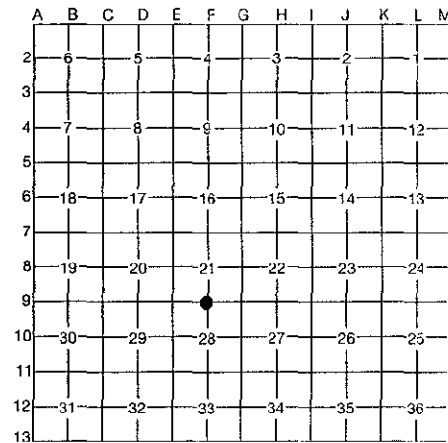

NOTE: Not more than 4 corners, all in the same town and range, may be recorded on this certificate.

A. Description of original monument and accessories and/or subsequent restoration:

1/4 Corner Sections 21 and 28, T52N, R39W

1845 -William A. Burt established 24" sugar section corner
 16" Y. Birch N 53° W 45 links

B. Description of corner evidence found and/or method applied in restoring or reestablishing corner:

Found no evidence of original corner and no record of subsequent perpetuation.

Found an east-west road (paved Paul Bunyun Ave. to west and gravel Ernest Road to east). Also found an old fenceline to the south and paved Putula Road to north. I held the centerline of the east-west road and the extension of the fenceline to south as the corner position. It works well with distant centerline of Putula Road - but road hooks to west just before intersection. This position works well with other corners in the area.


(Research on file with County Remonumentation Representative.)

C. Description of monument for corner and accessories established to perpetuate locating the position of the corner:

Corner is a 5/8" rerod with a 3" diameter stamped cap and falls on centerline of east-west road, 7' east of centerline Putula Road, and on the extension of a fenceline to the south.

Witnesses:

Power Pole #10	N 50° E	40.60'	PEER GROUP APPROVED <i>Paul W. Lepelcansky</i> 10-18-95 COUNTY REPRESENTATIVE
Anchor Pole	S 52° E	38.63'	
Reference Monument (Aluminum pipe with stamped aluminum cap)	South	22.00'	
14" Hard Maple	N 40° W	91.60'	

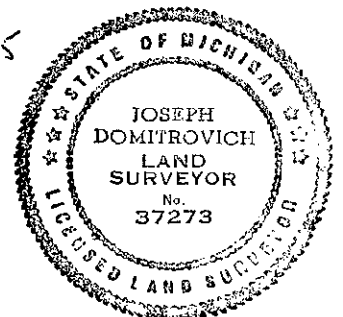

NOTE: Bearings are magnetic. Distances are to nail in side of witness objects unless noted.

Signed by J. C. Domitrovich Date 10/18/95
 Surveyor's Michigan License No. 37273

FORM APPROVED BY MICHIGAN STATE BOARD OF PROFESSIONAL SURVEYORS, JAN. 28, 1971
 REVISED MAY 14, 1973
 REVISED JAN., 1983