

**SURVEY & REMONUMENTATION**

APR 29 1996

**COMMISSION**

JUDITH D. ROEHN 10/19/95  
 Ontonagon County 14:53  
 LC 3/ 350 JEM Feet 9.00  
 Page 1 of 1

**LAND CORNER RECORDATION CERTIFICATE**  
 Filing Requirement of Act 74, Mich. P.A. 1970

For corners in Ontonagon (County) Located In: Corner Code #

1. Public Land Survey	T 52N R 39W	G-6
	T _____ R _____	_____
	T _____ R _____	_____
	T _____ R _____	_____
2. Property Controlling in Section	S _____ T _____ R _____	_____
	S _____ T _____ R _____	_____
3. Miscellaneous Property in Section	S _____ T _____ R _____	_____
	S _____ T _____ R _____	_____

4. Lot No. \_\_\_\_\_, Recorded Plat \_\_\_\_\_  
 5. Private Claims \_\_\_\_\_

Register of Deeds Stamp & File Number

A	B	C	D	E	F	G	H	I	J	K	L	M
2	6		5		4		3		2		1	
3												
4	7		8		9		10		11		12	
5												
6	18		17		16		15		14		13	
7												
8	19		20		21		22		23		24	
9												
10	30		29		28		27		26		25	
11												
12	31		32		33		34		35		36	
13												

I, Joseph C. Domitrovich, in a field survey on October 11, 1995, do hereby certify that under requirements of P.A. 74, Michigan P.A. of 1970, the corner points mentioned in lines 1 and 2 above were in conformance with regulations and rules therefore as required in the current manual of survey instructions of the United States Department of the Interior, Bureau of Land Management or by a decree of a Court of Law and/or that the corner points mentioned in lines 3, 4 and 5 above were in conformance with the rules of the Michigan Board of Professional Surveyors or by a Decree of a Court of Law; established, re-established, monumented, re-monumented, recovered, found as expressed below:

**NOTE: Not more than 4 corners, all in the same town and range, may be recorded on this certificate.**

**A. Description of original monument and accessories and/or subsequent restoration:**

1/4 Corner Sections 16 and 15, T52N R39W

1845 - William A. Burt set a fir post 1/4 Section Corner

- 6" Cedar N 30° E 21 links
- 6" Cedar N 29° W 20 links

1922 - E. J. Donnelly, C. E., noted on original notes on file at Ontonagon County Register of Deeds (p. 46) that he turned a right angle off of "Main Rd". (south line of section) and at 2626.2' north he was 86' east of a "sq. cor. in there." He then set up the section line parallel to the east line of Section 15, which moved the corner 17.4' west of his right angle line. (89° 37' 31" off of south line of section.) He put a stake on that line at 2640'.

1988 - Robert Mick P.S. 16936 in survey recorded in Liber 1, p. 100 of surveys shows the corner as an "I.R. pipe" 2578.43' north of the section corner.

**B. Description of corner evidence found and/or method applied in restoring or reestablishing corner:**

Found no evidence of the original corner due to the construction of N-S 4 Mile Rock Road. Found no evidence of Robert Mick corner, but did find a wood post and 1" pipe which falls in centerline of 4 Mile Rock Road and matches very closely the position re-established by E.J. Donnelly. (An angle of 89° 37' 17" off of the south line of the section, 2640.44 north of section corner.)

Also found 2 bearing trees with grown over blazes and nails in the side facing the found corner. Also found a 1" mushroomed pipe opposite the corner on the East R.O.W. 4 Mile Rock Road. The Donnelly corner appears to be the long accepted corner position. Placed county monument inside of the pipe.

PEER GROUP APPROVED

Paul W. Applbaum 10-18-95  
 COUNTY REPRESENTATIVE


(Research on file with County Remonumentation Representative.)

**C. Description of monument for corner and accessories established to perpetuate locating the position of the corner:**

Corner is a 5/8" rebar place inside the 1" pipe, with a 3" diameter stamped aluminum cap and falls 1" west of centerline 4 Mile Rock Road.

**Witnesses:**

- 1" mushroomed pipe East 32.27'
- Reference Monument (3/4" aluminum rod with 3" diameter stamped cap) East 22.00'
- 7" Soft Maple S 48° E 35.43' (Existing blaze and nail.)
- 4" Ash S 50° W 35.20'
- 12" Yellow Birch N 89° W 35.77' (Existing blaze and nail.)
- Sign Post East 22.73'

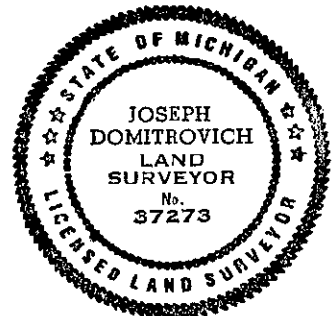

**NOTE: Bearings are magnetic. Distances are to nail in side of witness objects unless noted.**

Signed by Joseph C. Domitrovich

Date 10/18/95

Surveyor's Michigan License No. 37273