

SURVEY & REMONUMENTATION

APR 29 1996

JUDITH D. ROEHN 10/19/95
 Ontonagon County 14:29
 LC 3/347 JEM Fee: 9.00
 Page 1 of 1

COMMISSION

LAND CORNER RECORDATION CERTIFICATE
 Filing Requirement of Act 74, Mich. P.A. 1970

For corners in Ontonagon (County) Located In: _____ Corner Code # _____

1. Public Land Survey	T <u>52N</u> R <u>39W</u>	<u>G-9</u>
	T _____ R _____	_____
	T _____ R _____	_____
	T _____ R _____	_____
2. Property Controlling in Section	S _____ T _____ R _____	_____
	S _____ T _____ R _____	_____
3. Miscellaneous Property in Section	S _____ T _____ R _____	_____
	S _____ T _____ R _____	_____

4. Lot No. _____, Recorded Plat _____
 5. Private Claims _____

Register of Deeds Stamp & File Number

A	B	C	D	E	F	G	H	I	J	K	L	M
2	6	5	4	3	2	1						
3												
4	7	8	9	10	11	12						
5												
6	18	17	16	15	14	13						
7												
8	19	20	21	22	23	24						
9												
10	30	29	28	27	26	25						
11												
12	31	32	33	34	35	36						
13												

I, Joseph C. Domitrovich, in a field survey on October 12, 1995, do hereby certify that under requirements of P.A. 74, Michigan P.A. of 1970, the corner points mentioned in lines 1 and 2 above were in conformance with regulations and rules therefore as required in the current manual of survey instructions of the United States Department of the Interior, Bureau of Land Management or by a decree of a Court of Law and/or that the corner points mentioned in lines 3, 4 and 5 above were in conformance with the rules of the Michigan Board of Professional Surveyors or by a Decree of a Court of Law; established, re-established, monumented, re-monumented, recovered, found as expressed below:

NOTE: Not more than 4 corners, all in the same town and range, may be recorded on this certificate.

A. Description of original monument and accessories and/or subsequent restoration:

Corner of Sections 21, 22, 27 and 28, T52N, R39W

1845 -William A. Burt set sugar post
 14" Hemlock S 33° E 26 links
 14" Sugar N 48° W 33 links

1922 -E. J. Donnelly C.E., noted in original notes (p.42) on file at Ontonagon County Register of Deeds, that he found the original Hemlock bearing tree and used it to re-set the corner with a 2' iron "Lightening Rod". He also noted this corner fell 7 1/2' north and 5' west of an existing corner.

B. Description of corner evidence found and/or method applied in restoring or reestablishing corner:

Found a 2' long 3/4" square twisted iron (same type as set by Donnelly elsewhere in township) in a skidway in a heavily logged area. The Hemlock bearing tree has been obliterated along with any other original evidence.

The corner works well with others in area. Accepted corner position and replaced with a county monument.

(Research on file with County Remonumentation Representative.)


C. Description of monument for corner and accessories established to perpetuate locating the position of the corner:

Corner is an aluminum pipe with a 3" diameter stamped aluminum cap and falls in the northwest area of a logging skidway which is now an active beaver flooding.

Witnesses:

11" Hard Maple	N 08° E	13.03'
8" Ash	N 64° E	54.88'
4" Hard Maple	S 20° E	39.35'
5" Ash	N 75° W	42.15'
Sign Post	East	0.40'

PEER GROUP APPROVED
Paul W. Applekamp 10-18-95
 COUNTY REPRESENTATIVE

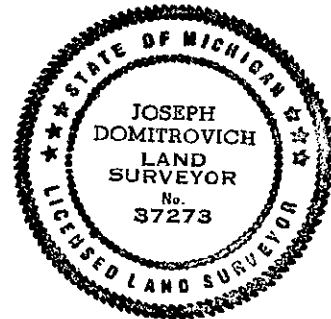

NOTE: Bearings are magnetic. Distances are to nail in side of witness objects unless noted.

Signed by J. C. Domitrovich Date 10/18/95
 Surveyor's Michigan License No. 37273