

**SURVEY &
REMONUMENTATION**

TIP

APR 29 1996

JUDITH D. ROEHM
Ontonagon County
LC 3/342 JEM Fee: 9.00
Page 1 of 1

COMMISSION LAND CORNER RECORDATION CERTIFICATE
Filing Requirement of Act 74, Mich. P.A. 1970

For corners in Ontonagon (County) Located In: _____ Corner Code # _____

1. Public Land Survey	T	<u>52N</u>	R	<u>39W</u>	<u>G-13</u>	
	T	_____	R	_____	_____	
	T	_____	R	_____	_____	
	T	_____	R	_____	_____	
2. Property Controlling in Section	S	_____	T	_____	R	_____
	S	_____	T	_____	R	_____
3. Miscellaneous Property in Section	S	_____	T	_____	R	_____
	S	_____	T	_____	R	_____

Register of Deeds Stamp & File Number

4. Lot No. _____, Recorded Plat _____
5. Private Claims _____

A	B	C	D	E	F	G	H	I	J	K	L	M
2	6	5	4	3	2	1						
3												
4	7	8	9	10	11	12						
5												
6	18	17	16	15	14	13						
7												
8	19	20	21	22	23	24						
9												
10	30	29	28	27	26	25						
11												
12	31	32	33	34	35	36						
13												

I, Joseph C. Domitrovich, in a field survey on October 18, 19 95 do hereby certify that under requirements of P.A. 74, Michigan P.A. of 1970, the corner points mentioned in lines 1 and 2 above were in conformance with regulations and rules therefore as required in the current manual of survey instructions of the United States Department of the Interior, Bureau of Land Management or by a decree of a Court of Law and/or that the corner points mentioned in lines 3, 4 and 5 above were in conformance with the rules of the Michigan Board of Professional Surveyors or by a Decree of a Court of Law; established, re-established, monumented, re-monumented, recovered, found as expressed below:

NOTE: Not more than 4 corners, all in the same town and range, may be recorded on this certificate.

A. Description of original monument and accessories and/or subsequent restoration:

Standard Section Corner, Sections 33 and 34, T52N, R39W

1845 -William A. Burt set Elm post


12" Sugar N 47° E 46 links
14" Y. Birch N 26° W 20 links

A closing corner was also established 40 links (26.40') to the east where the section line for Sections 4 and 3, T51N, R39W intersected the township line.

B. Description of corner evidence found and/or method applied in restoring or reestablishing corner:

Found no remains of original corner. Found a 3/4" square end twisted iron. (same type as set by E.J. Donnelly elsewhere in township) and a 2x2 wood post driven next to it. A beaver blazed Maple with an aluminum tag faces this corner.

Corner works well with others to north and west. Replaced corner with County Monument.

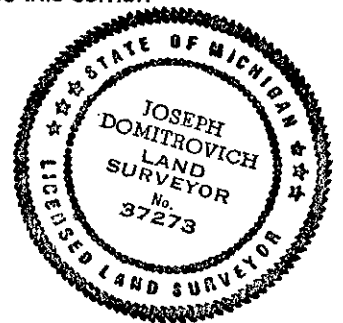

(Research on file with County Remonumentation Representative.)

C. Description of monument for corner and accessories established to perpetuate locating the position of the corner:

Corner is an aluminum pipe with a 3" diameter stamped aluminum cap.

Witnesses:

5" Soft Maple N 45° W 16.25'
Closing Corner Sections 4 and 3, T51N, R39W (Aluminum pipe with stamped aluminum cap) East 26.40'
Sign Post South 0.82'
16" Soft Maple with "Beaver Blaze" and aluminum tag S 18° W 7.55'
6" Soft Maple in clump N 71° W 12.64'

PEER GROUP APPROVED
Paul W. Applkamp 10-18-95
COUNTY REPRESENTATIVE

NOTE: Bearings are magnetic. Distances are to nail in side of witness objects unless noted.

Signed by Joseph C. Domitrovich Date 10/18/95

Surveyor's Michigan License No. 37273