

JUDITH D. ROEHM IP
LAND CORNER RECORDATION CERTIFICATE Ontonagon County
 Filing Requirement of Act 74, Mich. P.A. 1970 of 1 LC 5/ 97
 Ontonagon County Remonumentation Corner Rec. Date 06/25/98 Time 12:11

RECORDING FEE: 9.00

For corners in
 Ontonagon County Located in: Corner Code #
 1. Public Land Survey T52N R39W I-5
 T R
 T R
 T R
 2. Property Controlling S T R
 in Section S T R
 3. Miscellaneous S T R
 Property in Sec. S T R
 4. Lot No. , Recorded Plat
 5. Private Claims

REGISTERED
 SECTION
 JAN 11 1998
 SECTION
 Register of Deeds Stamp & File Number

I, Joseph C. Domitrovich, in a field survey on June 8, 1998, do hereby state that under requirements of P.A. 74, Michigan P.A. of 1970, the corner points mentioned in lines 1 and 2 above were in conformance with regulations and rules therefore as required in the current manual of survey instructions of the United States Department of the Interior, Bureau of Land Management or by a decree of a Court of Law and /or that the corner points mentioned in lines 3, 4 and 5 above were in conformance with the rules of the Michigan Board of Land Surveyors or by a Decree of a Court of Law, established, re-established, monumented, recovered, found as expressed below:

	A	B	C	D	E	F	G	H	I	J	K	L	H
1													
2	6	5	4	3	2	1							
3													
4	7	8	9	10	11	12							
5													
6	18	17	16	15	14	13							
7													
8	19	20	21	22	23	24							
9													
10	30	29	28	27	26	25							
11													
12	31	32	33	34	35	36							
13													

NOTE: Not more than 2 corners, all in the same town and range, may be recorded on this certificate.

A. Description of original monument and accessories and/or subsequent restoration:
(I-5) Corner Common to Sections 10, 11, 14, 15, T52N, R39W

- 1845 - William A. Burt set White Pine post.
 14" Black Oak S 60° E 13 links
 12" White Pine N 41° W 31 links
- 1954 - Ned Hawley, timbercruiser, noted in his personal copy of the original field notes that this corner is a 8" x 1/2" pipe established by J. Donnelly.
- 1978 - Robert Mick, P.S. 16936, in survey recorded in Liber 1, Page 40 of Surveys shows this corner as an iron pipe in swamp, well marked. He also shows a found pipe N 00° 39' 18" E 960.54' at the shore of Lake Superior.

B. Description of corner evidence found and/or method applied in restoring or reestablishing corner:

I found a 3/4" O.D. iron pipe at the corner with another thin wall galvanized pipe driven next to it. I found a fallen half rotten 20" +/- White Pine that matches the record bearing and distance to the original 12" White Pine bearing tree. I also found 2 large blazed White Pines facing the pipe. This pipe works well with corners called for and set in Bob Mick's survey as well as with other corners in the area.

I accepted the 3/4" O.D. pipe as the Section Corner.


Research on file with County Remonumentation Representative.

PEER GROUP APPROVED
Paul W. Speltkamp
 COUNTY REPRESENTATIVE 6-17-98

C. Description of monument for corner and accessories established to perpetuate locating the position of the corner:

Corner is a 2 1/2" x 30" aluminum pipe with a 3" diameter aluminum cap placed over the 3/4" pipe, stamped to read: COUNTY REMONUMENTATION; S.10, S.11, S.14, S.15; T.52N, R.39W; 1998; P.S. 37273.

- Witnesses:
- 20" White Pine S 05° W 59.11'
 - 24" White Pine N 60° W 27.14' (existing blaze)
 - 20" White Pine N 12° E 38.27' (existing blaze)
 - 18" Red Pine S 26° E 56.24'
 - Steel Sign Post South 1.77' (to face)
 - Meander Cor. Sec. 10 & 11 N 00° 50' 57" E 960.44'
 - S 1/4 Cor. Section 11 N 89° 09' 48" E 2616.04'

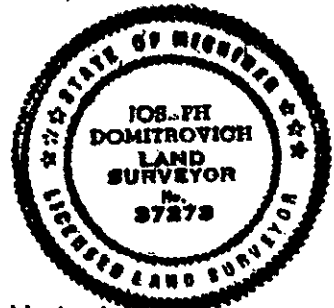

NOTE: Bearings to witness objects are magnetic. Distances are to a nail in side of the witness object unless noted.

Signed by Joseph C. Domitrovich
 Surveyor's Michigan License No. 37273

Date 6-17-98