

LAND CORNER RECORDATION CERTIFICATE
Filing Requirement of Act 74, Mich. P.A. of 1970
Ontonagon County Remonumentation Corner

REC'D OF 1 LC 5/100
REC. Date 06/25/98 Time 12:12
RECORDING FEE: 9.00

For corners in

Table with 3 columns: Ontonagon County, Located in:, Corner Code #. Rows include Public Land Survey, Property Controlling in Section, Miscellaneous Property in Sec., Lot No., and Private Claims.

SURVEY &
RECORDATION

JAN 11 1998

SECTION

Register of Deeds Stamp & File Number

I, Joseph C. Domitrovich, in a field survey on May 27, 1998, do hereby state that under requirements of P.A. 74, Michigan P.A. of 1970, the corner points mentioned in lines 1 and 2 above were in conformance with regulations and rules therefore as required in the current manual of survey instructions of the United States Department of the Interior, Bureau of Land Management or by a decree of a Court of Law and/or that the corner points mentioned in lines 3, 4 and 5 above were in conformance with the rules of the Michigan Board of Land Surveyors or by a Decree of a Court of Law, established, re-established, monumented, recovered, found as expressed below:

NOTE: Not more than 2 corners, all in the same town and range, may be recorded on this certificate.

A. Description of original monument and accessories and/or subsequent restoration:
(K-5) Corner Common to Sections 11, 12, 13 & 14, T52N, R39W

1845 - William A. Burt Set post
12' Hemlock S 28° E 29 links
12' Cedar N 32° W 39 links

1954 - Ned and John Hawley, timbercruisers, noted in their personal copy of the original field notes that they found a cedar stake marked "Slater, 8-13-47" and that it fell 8 feet West of an 8' 'popple' squared on 4 sides. They placed a six foot long 1" black pipe, painted yellow, at location of old stake.

B. Description of corner evidence found and/or method applied in restoring or reestablishing corner:

I found no remains of the original corner or accessories. I found the pipe called for by the Hawleys lying flat on the ground. I stood it up at its approximate original position. At its base, I found the remains and point of a wood post. Distances from this post to corners North, South, West and to the centerline of a N-S 1/4 line road to the East, work well. I accepted the wood post as the Section corner and monumented it as such.

Table with 4 columns: Description, Bearing, Distance, and GLO. Rows include NE Cor. Section 11, E 1/4 Cor. Section 14, S 1/4 Cor. Section 11, and E-W fence & Centerline 1/4 line Rd.

Research on file with County Remonumentation Representative.


C. Description of monument for corner and accessories established to perpetuate locating the position of the corner:

Corner is a 2 1/2" x 30" aluminum pipe with a 3" diameter aluminum cap stamped to read: COUNTY REMONUMENTATION; S.11, S.12, S.13, S.14; T.52N, R.39W; 1998; P.S. 37273.

Witnesses:

Table with 3 columns: Witness, Bearing, Distance. Rows include 6" Cedar, 1" Iron Pipe, 8" Spruce, 8" Spruce, 7" Twin Maple, Steel Sign Post, and 24" Poplar.

PEER GROUP APPROVED
[Signature]
COUNTY REMONUMENTATION

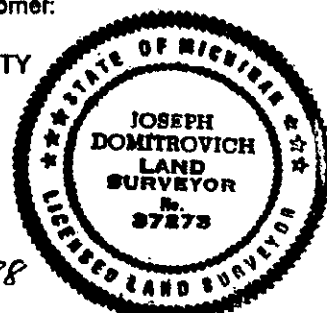

(to face)
(blazed on 4 sides; 8" Poplar called for by Hawleys)

NOTE: Bearings to witness objects are magnetic. Distances are to a nail in side of the witness object unless noted.

Signed by [Signature]

Date 6-17-98

Surveyor's Michigan License No. 37273