


LAND CORNER RECORDATION CERTIFICATE
Filing Requirement of Act 74, Mich. P.A. 1970

For corners in Ontonagon Located In: Corner Code #
 (County)

1. Public Land Survey T 52N R 40W Corner Code # H-13
 T R
 ↑ ↓

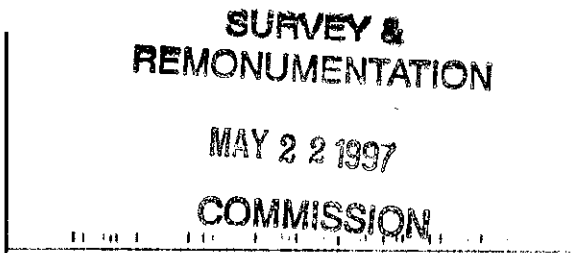

4. Lot No. _____, Recorded Plat _____
 5. Private Claims _____

A	B	C	D	E	F	G	H	I	J	K	L	M
2	6	5	4	3	2	1						
3												
4	7	8	9	10	11	12						
5												
6	18	17	16	15	14	13						
7												
8	19	20	21	22	23	24						
9												
10	30	29	28	27	26	25						
11												
12	31	32	33	34	35	36						
13												

I, Joseph C. Domitrovich, in a field survey on August 5, 1996, do hereby certify that under requirements of P.A. 74, Michigan P.A. of 1970, the corner points mentioned in lines 1 and 2 above were in conformance with regulations and rules therefore as required in the current manual of survey instructions of the United States Department of the Interior, Bureau of Land Management or by a decree of a Court of Law and/or that the corner points mentioned in lines 3, 4 and 5 above were in conformance with the rules of the Michigan Board of Professional Surveyors or by a Decree of a Court of Law; established, re-established, monumented, re-monumented, recovered, found as expressed below:

NOTE: Not more than 4 corners, all in the same town and range, may be recorded on this certificate.

A. Description of original monument and accessories and/or subsequent restoration:

(H-13) South 1/4 Corner Section 34, T52N, R40W.

1845 - William A. Burt, set fir 1/4 post
 24" Hemlock N 38° E 13 links
 14" Maple N 37° W 32 links

1928 - E.J. Donnelly C.E. did not set corner but notes it was established by single proportionate measurement for Supervisor Carroll's plat of Government Lots 3 and 4, Section 34, T52N, R40W.

1979 - Robert Mick, P.S. 16936 set concrete monument by single proportionate measurement between standard corners to the east and west. He noted that he also set the North 1/4 corner Section 3, T51N, R40W, 38.94' to the east. (Done for the Ontonagon County Airport, survey on file with plats at Ontonagon County Register of Deeds.)

B. Description of corner evidence found and/or method applied in restoring or reestablishing corner:

All remains of the original corner and accessories have been destroyed.

I found the concrete monument as called for in the Mick survey. The top portion had been peeled off. The monument fell in the centerline of an abandoned driveway.

This position works well with Mick distances to the east and west. It does not work well with Supervisor Carroll's Plat. It appears that Donnelly mistakenly used the closing corner to the west as a common corner when he set up his plat.

I accepted the Mick corner as the correct South 1/4 corner of Section 34 and replaced the disturbed monument with a 5/8" rebar and cap.

Research on file with County Remonumentation Representative.


C. Description of monument for corner and accessories established to perpetuate locating the position of the corner:

Corner is a 5/8" x 24" rebar with a 3" diameter aluminum cap stamped to read: T.52N., R.40W.; 1/4 S.34; 1996; P.S. 37273. Corner falls in centerline of abandoned driveway and 38.86" west of the North 1/4 corner of Section 3, T51N, R40W.

Witnesses:

Steel Sign Post	North	23.04'		
North 1/4 Corner Sec.3 (capped concrete monument)	East	38.86'		
4" Poplar	S 45° E	23.57'		
Twin 6" Apple Tree	S 35° W	41.16'		
7" Soft Maple	N 51° W	30.51'		

PEER GROUP APPROVED
Carl W. Applekamp
 COUNTY REPRESENTATIVE 08-08-96

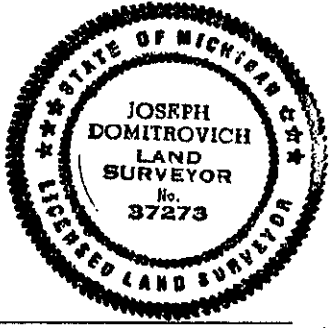

NOTE: Bearings are magnetic. Distances are to nail in side of witness objects unless noted.

Signed by J. C. Domitrovich Date 8/8/96

Surveyor's Michigan License No. 37273