


LAND CORNER RECORDATION CERTIFICATE
Filing Requirement of Act 74, Mich. P.A. 1970

For corners in Ontonagon Located In: _____ Corner Code # _____
 (County)

1. Public Land Survey	T <u>52N</u> R <u>40W</u>	<u>I-13</u>
	T _____ R _____	_____
	T _____ R _____	_____
	T _____ R _____	_____
2. Property Controlling in Section	S _____ T _____ R _____	_____
	S _____ T _____ R _____	_____
3. Miscellaneous Property in Section	S _____ T _____ R _____	_____
	S _____ T _____ R _____	_____

4. Lot No. _____, Recorded Plat _____
 5. Private Claims _____

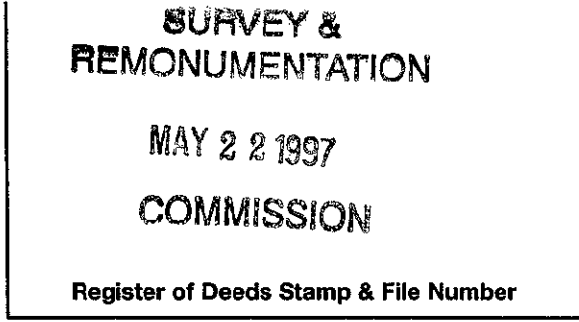

A	B	C	D	E	F	G	H	I	J	K	L	M
2	6	5	4	3	2	1						
3												
4	7	8	9	10	11	12						
5												
6	18	17	16	15	14	13						
7												
8	19	20	21	22	23	24						
9												
10	30	29	28	27	26	25						
11												
12	31	32	33	34	35	36						
13												

I, Joseph C. Domitrovich, in a field survey on August 5, 1996, do hereby certify that under requirements of P.A. 74, Michigan P.A. of 1970, the corner points mentioned in lines 1 and 2 above were in conformance with regulations and rules therefore as required in the current manual of survey instructions of the United States Department of the Interior, Bureau of Land Management or by a decree of a Court of Law and/or that the corner points mentioned in lines 3, 4 and 5 above were in conformance with the rules of the Michigan Board of Professional Surveyors or by a Decree of a Court of Law; established, re-established, monumented, re-monumented, recovered, found as expressed below:

NOTE: Not more than 4 corners, all in the same town and range, may be recorded on this certificate.

A. Description of original monument and accessories and/or subsequent restoration:

- (I-13) Standard Corner Sections 34 & 35, T52N, R40W
1845 - William A. Burt, set Maple Post 22" Hemlock N 45° E 59 links
 8" Y. Birch N 33° W 36 links
1922 - E.J. Donnelly noted in copies of original field notes at Ontonagon Co. Register of Deeds that he drove 2 pieces of 2"x1" square reinforcing rod at this corner while bearing trees were here before J Schaffer cleared for a road.
1979 - Robert Mick, P.S. 16936, in survey for Ontonagon County Airport (on file with Plats at Ontonagon Co. Register of Deeds) found a 1" square iron rod "possibly by Donnelly in 1922". He accepted it as the standard corner and gave 2 witnesses (Note - witnesses to this corner and closing corner are reversed on drawing.) He also set the closing corner at the GLO distance (34.32') to the east.

B. Description of corner evidence found and/or method applied in restoring or reestablishing corner:

All remains of original corner and accessories have been destroyed by farming and road construction.
 I found the 1" square reinforcing bar as set by Donnelly and the witnesses noted in Mick Survey. Distances from this corner are consistent with Mick distances to west and south. I also recovered the remains of the concrete monument set by Mick for the closing corner to the east.
 I accepted the 1" square reinforcing bar as the standard corner and have monumented it as such.


Research on file with County Remonumentation Representative.

PEER GROUP APPROVED
Earl W. Applikamp
 COUNTY REPRESENTATIVE 08-08-96

C. Description of monument for corner and accessories established to perpetuate locating the position of the corner:

Corner is a 2" x 30" aluminum pipe with a 3" diameter aluminum cap stamped to read: T.52N., R40W.; S.34, S.35; S.C.; 1996; P.S. 37273. Corner falls 30' west of Centerline North-South Noble Road and in line with fences to east and west.

- Witnesses:
 20" Scotch Pine S 22° W 8.16'
 7" Soft Maple West 39.31'
 Steel Sign Post West 0.95'
 Closing Corner Sections 2 & 3, T51N, R40W East 34.30" (5/8" rebar with Aluminum cap)
 Power Pole East 56.26'

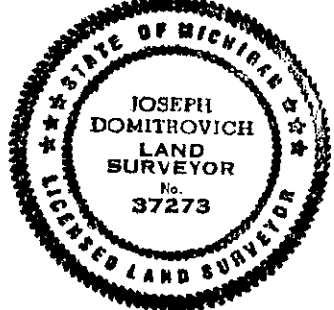

NOTE: Bearings are magnetic. Distances are to nail in side of witness objects unless noted.

Signed by J. C. Domitrovich Date 8/8/96
 Surveyor's Michigan License No. 37273