

LAND CORNER RECORDATION CERTIFICATE
Filing Requirement of Act 74, Mich. P.A. 1970

For corners in Ontonagon Located In: _____ Corner Code # _____
 (County)

1. Public Land Survey T 52N R40W J-11
 T _____ R _____
 T _____ R _____
 T _____ R _____

2. Property Controlling S _____ T _____ R _____
 in Section S _____ T _____ R _____

3. Miscellaneous S _____ T _____ R _____
 Property in Section S _____ T _____ R _____

**SURVEY &
 REMONUMENTATION**

MAY 22 1997

COMMISSION

Register of Deeds Stamp & File Number

4. Lot No. _____, Recorded Plat _____
 5. Private Claims _____

A	B	C	D	E	F	G	H	I	J	K	L	M
2	6	5	4	3	2	1						
3												
4	7	8	9	10	11	12						
5												
6	18	17	16	15	14	13						
7												
8	19	20	21	22	23	24						
9												
10	30	29	28	27	26	25						
11												
12	31	32	33	34	35	36						
13												

I, Joseph C. Domitrovich, in a field survey on September 5, 1996, do hereby certify that under requirements of P.A. 74, Michigan P.A. of 1970, the corner points mentioned in lines 1 and 2 above were in conformance with regulations and rules therefore as required in the current manual of survey instructions of the United States Department of the Interior, Bureau of Land Management or by a decree of a Court of Law and/or that the corner points mentioned in lines 3, 4 and 5 above were in conformance with the rules of the Michigan Board of Professional Surveyors or by a Decree of a Court of Law; established, re-established, monumented, re-monumented, recovered, found as expressed below:

NOTE: Not more than 4 corners, all in the same town and range, may be recorded on this certificate.

A. Description of original monument and accessories and/or subsequent restoration:

(J-11) 1/4 Corner Common to Sections 26 & 35, T 52N, R40W

- 1845** - William A. Burt set post
 12" W. Pine N29° W 66 links
 12" Hemlock South 47 links
- 1947** - D.E. Crooker, Subdivision of Government Lot 2, Section 26, T52N, R40W, by T.H. Wilcox, P.E., shows the corner as the point of beginning of the plat and shows concrete monuments on the section line to the East.
- 1969** - Ed Charles, P.S.12580, in a survey on Section 35, shows a railroad spike on the North-South 1/4 line at the intersection of old M-64 and Norwich Rd. He shows the railroad spike as being 986.20' South of the 1/4 Corner.

B. Description of corner evidence found and/or method applied in restoring or reestablishing corner:

Original corner and accessories have been destroyed by shoreline erosion and road construction. I recovered the plat monuments on the section line to the East and the railroad spike in the intersection to the South. I held the railroad spike as being on the true North-South 1/4 line and intersected N-S 1/4 line with a line through plat monuments on the section line to re-establish corner position.

Distances: East to Plat Monuments 1320' (PLAT) 1320.87' (M)
 South to Railroad Spike 986.20' (R) 986.11' (M)

Distances work well.


Research on file with County Remonumentation Representative.

C. Description of monument for corner and accessories established to perpetuate locating the position of the corner:

Corner is a 3/4" x 72" aluminum rod with a 3" diameter aluminum cap stamped to read: 1/4 S.26, S.35, T.52N, R.40W; 1996; P.S. 37273; County Remonumentation. I also established a Reference Monument (R.M. 1) to the South on the North-South 1/4 line, a 5/8" x 24" rebar with a 3" diameter aluminum cap stamped to indicate the 1/4 corner is North 113.00'. I also established a Reference Monument (R.M. 2) on the section line to the East, a 5/8" x 48" rebar with a 3" diameter aluminum cap stamped to indicate that the corner is West 39.33'. The Corner falls in beach.

R.M. 1 S 00° 15' 22" E 113.00'
 R.M. 2 N 89° 46' 46" E 39.33'
 Steel Sign Post S 32° W 62.18'
 18" Soft Maple S 73° E 22.98'
 8" W. Birch S 23° E 28.37'

PEER GROUP APPROVED
Earl W. Applekamp
 COUNTY REPRESENTATIVE
 10-16-96

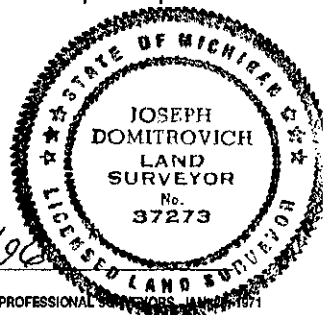

NOTE: Bearings are magnetic. Distances are to nail in side of witness objects unless noted.

Signed by Joseph C. Domitrovich Date 10/15/96

Surveyor's Michigan License No. 37273