

DEC 16 1996

COMMISSION

JUDITH D. ROEHM 07/12/96  
Ontonagon County 15:08  
LC 47 135 JEM Fee: 9.00  
Page 1 of 1

LAND CORNER RECORDATION CERTIFICATE  
Filing Requirement of Act 74, Mich. P.A. 1970

For corners in Ontonagon Located In: \_\_\_\_\_ Corner Code # \_\_\_\_\_  
(County)

1. Public Land Survey T 52N R 40W K-11  
T \_\_\_\_\_ R \_\_\_\_\_  
T \_\_\_\_\_ R \_\_\_\_\_  
T \_\_\_\_\_ R \_\_\_\_\_

2. Property Controlling S \_\_\_\_\_ T \_\_\_\_\_ R \_\_\_\_\_  
in Section S \_\_\_\_\_ T \_\_\_\_\_ R \_\_\_\_\_

3. Miscellaneous S \_\_\_\_\_ T \_\_\_\_\_ R \_\_\_\_\_  
Property in Section S \_\_\_\_\_ T \_\_\_\_\_ R \_\_\_\_\_

4. Lot No. \_\_\_\_\_, Recorded Plat \_\_\_\_\_

5. Private Claims \_\_\_\_\_

Register of Deeds Stamp & File Number

A	B	C	D	E	F	G	H	I	J	K	L	M
2	6	5	4	3	2							
3												
4	7	8	9	10	11	12						
5												
6	18	17	16	15	14	13						
7												
8	19	20	21	22	23	24						
9												
10	30	29	28	27	26	25						
11												
12	31	32	33	34	35	36						
13												

I, Joseph C. Domitrovich, in a field survey on June 17, 1996, do hereby certify that under requirements of P.A. 74, Michigan P.A. of 1970, the corner points mentioned in lines 1 and 2 above were in conformance with regulations and rules therefore as required in the current manual of survey instructions of the United States Department of the Interior, Bureau of Land Management or by a decree of a Court of Law and/or that the corner points mentioned in lines 3, 4 and 5 above were in conformance with the rules of the Michigan Board of Professional Surveyors or by a Decree of a Court of Law; established, re-established, monumented, re-monumented, recovered, found as expressed below:

NOTE: Not more than 4 corners, all in the same town and range, may be recorded on this certificate.

A. Description of original monument and accessories and/or subsequent restoration:

(K-11) Corner of Sections 25, 26, 35, & 36

- 1845 - William A. Burt set post  
24" Hemlock N 83° E 19 links  
22" Hemlock S 85° W 5 links
- 1923 - E.J. Donnelly C.E. placed a 3" pipe at this corner, having re-establish it using Natural Features, GLO distances and testimony of longtime resident. He used this corner in the Assessor's plat of the SE 1/4 of the SW 1/4 of section 25 in the same year. Since that time the 3" pipe has been used by the Michigan State Highway Department, U.S. Army Corps of Engineers and by private surveyors in numerous boundary surveys.

B. Description of corner evidence found and/or method applied in restoring or reestablishing corner:

Found a 4" O.D. iron pipe at the top of a steep slope to the south. Found 3 dead Birch Bearing trees used by M.S.H.D. and Robert Mick P.S. 16936. Also found two additional live bearing trees with a tag no. 24591 (Bob Crampton) in the face of tree.

Distances measured east and south from this pipe are consistent with those measured by Donnelly in 1923. This corner works well with others in the area.

I accepted pipe as the Section Corner and monumented it as such.

Research on file with County Remonumentation Representative.


PEER GROUP APPROVED  
Paul W. Applekamp  
COUNTY REPRESENTATIVE

C. Description of monument for corner and accessories established to perpetuate locating the position of the corner:

Corner is a 3/4" x 36" aluminum rod with a 3" diameter aluminum cap stamped to read: S.25, S.26, S.35, S.36; T.52N, R.40W.; 1996; P.S. 37273. This was place inside the found 4" pipe.

Witnesses:

- 12" White Birch N 22° E 15.85'
- 4" Soft Maple N 53° E 6.63' (Nail and tag #24591 in face)
- 8" Soft Maple S 54° W 8.45' (Nail and tag #24591 in face)
- 3" Balsam N 44° W 8.34'

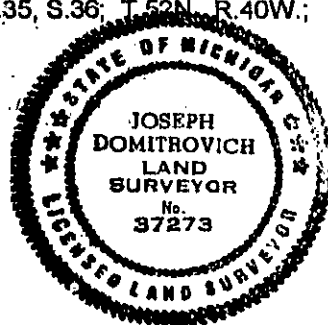

NOTE: Bearings are magnetic. Distances are to nail in side of witness objects unless noted.

Signed by J.C. Domitrovich Date 7/3/96  
Surveyor's Michigan License No. 37273