

SURVEY & REMONUMENTATION

DEC 16 1996

COMMISSION

JUDITH D. ROEHM
 Ontonagon County
 LC 4/ 132 JEM Feet 9.00
 07/12/96
 15:05
 Page 1 of 1

LAND CORNER RECORDATION CERTIFICATE
Filing Requirement of Act 74, Mich. P.A. 1970

For corners in Ontonagon Located In: _____ Corner Code # _____
 (County)

- | | | | | | |
|--------------------------------------|---|------------|---|------------|-------------|
| 1. Public Land Survey | T | <u>52N</u> | R | <u>40W</u> | <u>K-12</u> |
| | T | _____ | R | _____ | _____ |
| | T | _____ | R | _____ | _____ |
| | T | _____ | R | _____ | _____ |
| 2. Property Controlling in Section | S | _____ | T | _____ | R |
| | S | _____ | T | _____ | R |
| 3. Miscellaneous Property in Section | S | _____ | T | _____ | R |
| | S | _____ | T | _____ | R |

Register of Deeds Stamp & File Number

4. Lot No. _____, Recorded Plat _____
 5. Private Claims _____

I, Joseph C. Domitrovich, in a field survey on June 20, 1996, do hereby certify that under requirements of P.A. 74, Michigan P.A. of 1970, the corner points mentioned in lines 1 and 2 above were in conformance with regulations and rules therefore as required in the current manual of survey instructions of the United States Department of the Interior, Bureau of Land Management or by a decree of a Court of Law and/or that the corner points mentioned in lines 3, 4 and 5 above were in conformance with the rules of the Michigan Board of Professional Surveyors or by a Decree of a Court of Law; established, re-established, monumented, re-monumented, recovered, found as expressed below:

NOTE: Not more than 4 corners, all in the same town and range, may be recorded on this certificate.

| | | | | | | | | | | | | | |
|----|----|---|----|---|----|---|----|---|----|---|----|---|---|
| | A | B | C | D | E | F | G | H | I | J | K | L | M |
| 2 | 0 | | 5 | | 4 | | 3 | | 2 | | | | |
| 3 | | | | | | | | | | | | | |
| 4 | 7 | | 6 | | 9 | | 10 | | 11 | | 12 | | |
| 5 | | | | | | | | | | | | | |
| 6 | 18 | | 17 | | 16 | | 15 | | 14 | | 13 | | |
| 7 | | | | | | | | | | | | | |
| 8 | 19 | | 20 | | 21 | | 22 | | 23 | | 24 | | |
| 9 | | | | | | | | | | | | | |
| 10 | 30 | | 29 | | 28 | | 27 | | 26 | | 25 | | |
| 11 | | | | | | | | | | | | | |
| 12 | 31 | | 32 | | 33 | | 34 | | 35 | | 36 | | |
| 13 | | | | | | | | | | | | | |

A. Description of original monument and accessories and/or subsequent restoration:

(K-12) 1/4 Corner common to Sections 35 & 36, T52N, R40W

- 1845 - William A. Burt set Maple post
 10" Hemlock N 54° E 39 links
 14" Y. Birch N 59° W 16 links
- 1923 - E.J. Donnelly C.E. found an iron pin set at location of original Government stake per testimony of 90 year old resident. Shows distances north and south to Section corners.
- 1945 - M-64 R.O.W. plans show corner at same distance as Donnelly from Section corner to the north.
- 1988 - Ed Charles P.S. 125809 in survey recorded Liber 1, page 56, of surveys shows a found I.P. and a distance west to center 1/4 corner.
- 1989 - Bob Mick P.S. 16936 in survey recorded in Liber 1, page 109 of surveys shows found corner and a different west to center 1/4 corner.
- 1992 - Bob Crampton P.S. 26591, per phone conversation, told me he used the Ed Charles corner for surveys he did in Section 35.

B. Description of corner evidence found and/or method applied in restoring or reestablishing corner:

Original Corner and accessories have been destroyed by an east-west paved road over corner location. I found at the corner position: a 1" square iron pin 2' north of centerline matching Bob Mick survey position, and a 3/4" iron pin 1.5' south of centerline matching the Ed Charles and Bob Crampton position. Both pins are reasonably close to the E.J. Donnelly 1/4 corner position.

In doing further section work in Section 35, I discovered that the 3/4" iron pin falls within a foot of a single-prorated position. I also discovered that the 3/4" iron pin had been used to set the center 1/4 corner of Section 35, now in a 4-way intersection and has been used in a large number of surveys. Therefore I have accepted the 3/4" iron pin (Charles/Crampton position) and have monumented it as such.

Research on file with County Remonumentation Representative.

PEER GROUP APPROVED
Carl W. Applekamp
 COUNTY REPRESENTATIVE 07-08-96


C. Description of monument for corner and accessories established to perpetuate locating the position of the corner:

Corner is a 2" x 30" rebar with a 3" diameter aluminum cap stamped to read: 1/4 S. 35, S.36; T.52N., R.40W.; 1996; P.S. 37273. Also set a Reference Monument, a 2" x 30" aluminum pipe with a 3" aluminum cap stamped to indicate the 1/4 corner is north 35.93'

Witnesses:

- 14" White Birch N 39° E 81.48' (26591 nail & tag in face)
- 7" Hard Maple S 35° E 61.27' (26591 nail & tag in face)
- Reference Monument South 35.93'
- 7" Hard Maple S 63° W 55.81'
- Power Pole N 48° W 47.18' (26591 nail & tag in face/nail & brass tag in side)
- 1" Square Iron Pin N 54° W 5.63' (Mick corner)

NOTE: Bearings are magnetic. Distances are to nail in side of witness objects unless noted.

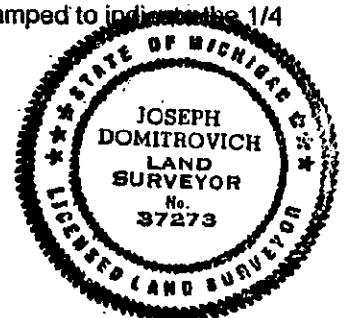

Signed by J. C. Domitrovich Date 7/3/96
 Surveyor's Michigan License No. 37273