

**SURVEY &
REMONUMENTATION**

APR 26 1996

COMMISSION LAND CORNER RECORDATION CERTIFICATE
Filing Requirement of Act 74, Mich. P.A. 1970

For corners in

Ontonagon
(County)

Located in:

Corner Code #1

- | | | | |
|---------------------------------------|-------------------|--|--------------|
| 1. Public Land Survey S-30 | T 52NR 39W | | |
| | T 52NR 40W | | A-10
M-10 |
| | T ___ R ___ | | |
| | T ___ R ___ | | |
| 2. Property Controlling in Section | S ___ T ___ R ___ | | |
| | S ___ T ___ R ___ | | |
| 3. Miscellaneous Property in Sec. | S ___ T ___ R ___ | | |
| | S ___ T ___ R ___ | | |
| 4. Lot No. _____, Recorded Plat _____ | | | |
| 5. Private Claims _____ | | | |

Recorded August 31 1994
at 2:05 o'clock P. M. in
Liber 3 page 204
Julie Mailey Deputy
Register of Deeds

Register of Deeds Stamp & File Number

July 25 94

I, John R. Garske, in a field survey on _____, 19____, do hereby certify that under requirements of P.A. 74, Michigan P.A. of 1970, the corner points mentioned in lines 1 and 2 above were in conformance with regulations and rules therefore as required in the current manual of survey instructions of the United States Department of the Interior, Bureau of Land Management or by a decree of a Court of Law and/or that the corner points mentioned in lines 3, 4 and 5 above were in conformance with the rules of the Michigan Board of Land Surveyors or by a Decree of a Court of Law; established, re-established, monumented, re-monumented, recovered, found as expressed below:

	A	B	C	D	E	F	G	H	I	J	K	L	M
2	6	5	4	3	2	1							
3													
4	7	8	9	10	11	12							
5													
6	18	17	16	15	14	13							
7													
8	19	20	21	22	23	24							
9													
10	30	29	28	27	26	25							
11													
12	31	32	33	34	35	36							
13													

NOTE: Not more than 4 corners, all in the same town and range, may be recorded on this certificate.

A. Description of original monument and accessories and/or subsequent restoration:

August 26, 1845 - William A. Burt, U.S. Deputy Surveyor, set post:

- Fir 8" - N63°E, 15 links (9.90')
- Fir 9" - N20°W, 21 links (13.86')

Various plats in Ontonagon refer to 1/4 corner.

1980 Ewart Muller (Coleman Engineering) survey shows conc. monument at 1/4 corner.

B. Description of corner evidence found and/or method applied in restoring or reestablishing corner:

Found 5" x 5" concrete monument in lawn area west of north Steel Street and northwesterly of Copper Street. Monument had a chiseled center mark on it but no iron rod in it. Accepted found conc. monument as 1/4 corner as it has been used in various surveys of record and is generally accepted as marking the 1/4 corner position.

Research on file with County Remonumentation Program Representative


ONTONAGON COUNTY
PEER APPROVED

Earl Applekamp Co. Rep.
8-17-94

Description of monument for corner and accessories established to perpetuate locating the position of the corner:

Drilled concrete monument and epoxied a stamped 2 1/2" brass tablet in top center of existing concrete monument. Established the following accessories:

- Power pole #100 - N69°E, 74.79'
- Power pole #74 - S10°W, 93.05'
- NE'y corner of block foundation of house - west, 37.11'
- Made punch mark in center of manhole cover - N07°W, 21.35'

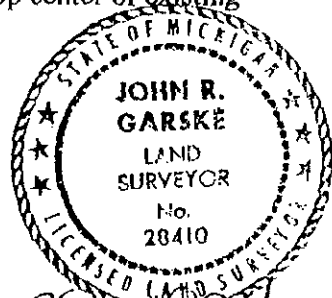

Witnessed by John R. Garske
Surveyor's Michigan License No. 28410

Date Aug 29, 1994