

**SURVEY & REMONUMENTATION**

APR 26 1996

**COMMISSION**

**LAND CORNER RECORDATION CERTIFICATE**  
**Filing Requirement of Act 74, Mich. P.A. 1970**

For corners in

ONTONAGON  
 (County)

Located In:	Corner Code #
53 38	A-13
T 52 R 39	M-1
T 53N R 39W	M-13
T 52N R 38W	A-1
T _____ R _____	_____
S _____ T _____ R _____	_____
S _____ T _____ R _____	_____
S _____ T _____ R _____	_____

Recorded November 16 1994  
 at 1:20 o'clock P. M. in  
 Liber 3 page 219  
*Judith Marley*  
 Register of Deeds


Register of Deeds Stamp & File Number

1. Public Land Survey  
 2. Property Controlling in Section  
 3. Miscellaneous Property in Sec.  
 4. Lot No. \_\_\_\_\_, Recorded Plat \_\_\_\_\_  
 5. Private Claims \_\_\_\_\_

Section Corner Section 1, 36, 31 & 6, T52N R39-38W

I, Earl W. Applekamp, in a field survey on September 03, 19 94, do hereby certify that under requirements of P.A. 74, Michigan P.A. of 1970, the corner points mentioned in lines 1 and 2 above were in conformance with regulations and rules (hereof as required in the current manual of survey instructions of the United States Department of the Interior, Bureau of Land Management or by a decree of a Court of Law and/or that the corner points mentioned in lines 3, 4 and 5 above were in conformance with the rules of the Michigan Board of Land Surveyors or by a Decree of a Court of Law; established, re-established, monumented, re-monumented, recovered, found as expressed below:

**NOTE: Not more than 4 corners, all in the same town and range, may be recorded on this certificate.**

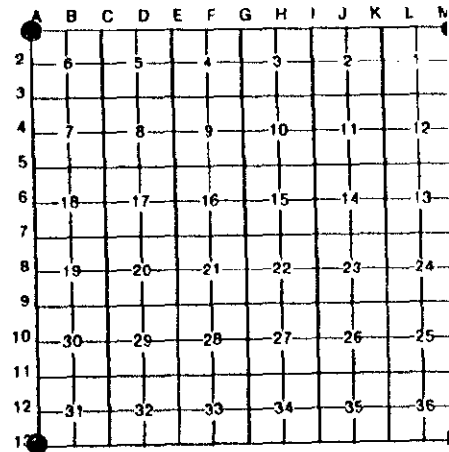

A. Description of original monument and accessories and/or subsequent restoration:

Corner established by William A. Burt U.S. Deputy Surveyor, in September, 1845. Set Maple Post.

Original bearing trees:

Maple	10"	N12°E	21 Links	(13.86')
Hemlock	22"	S47°W	29 Links	(19.14')

**ONTONAGON COUNTY**  
**PEER APPROVED**

*Earl W. Applekamp*  
 ONT. CO. REP.  
 9-14-94

B. Description of corner evidence found and/or method applied in restoring or reestablishing corner:

At the corner location I found a 1½" O.D. pipe 2 feet high. The remains of a Hemlock stump at the original call distance and bearing was found. Several blazed trees were around the corner. These blazes were 60-70 years old.



C. Description of monument for corner and accessories established to perpetuate locating the position of the corner:

At the corner position I set a 2¼" aluminum pipe with a 3½" Cap, stamped to read: County Remonumentation; S-36, S-31, S-1, S-6; T53N R38W & T52N R38-39W; 1994, P.S. 17610

The following trees and objects were used to tie in the corner?

6" Y. Birch	N74°E	16.12 feet	-	10" Cedar	S10°W	15.42 feet
10" Cedar	N14°E	17.05 feet	-	Steel sign post	West	1.35 feet

Signed by Earl W. Applekamp  
 Surveyor's Michigan License No. 17610

Date November 11, 1994

219