LAND CORNER RECORDATION CERTIFICATE

Filing Requirement of Act 74, Mich. P.A. 1970

For corners in
Presque Isle
(County)

Located In: Corner Code 11

1. Public Land Survey — T 33N R 2E
2. Property Controlling in Section — S 17 T ___ R ___ — 8, 4, 3
3. Miscellaneous Property in Sec. — S ___ T ___ R ___

Register of Deeds Stamp & File Number

4. Lot No. _____ , Recorded Plat _____
5. Private Claims _____

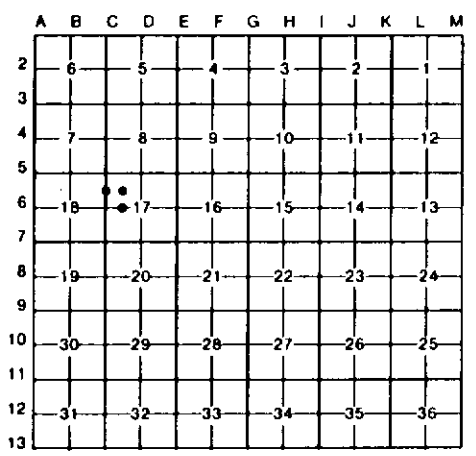

I, Carl R. Johnson, in a field survey on April 8, 19 91, do hereby certify that under requirements of P.A. 74, Michigan P.A. of 1970, the corner points mentioned in lines 1 and 2 above were in conformance with regulations and rules therefore as required in the current manual of survey instructions of the United States Department of the Interior, Bureau of Land Management or by a decree of a Court of Law and/or that the corner points mentioned in lines 3, 4 and 5 above were in conformance with the rules of the Michigan Board of Land Surveyors or by a Decree of a Court of Law; established, re-established, monumented, re-monumented, recovered, found as expressed below:

NOTE: Not more than 4 corners, all in the same town and range, may be recorded on this certificate.

A. Description of original monument and accessories and/or subsequent restoration:

8	4	3

B. Description of corner evidence found and/or method applied in restoring or reestablishing corner:

8	4	3
Corner established by standard survey procedure for subdivision of a section	Corner established by standard survey procedure for subdivision of a section	Corner established by standard survey procedure for subdivision of a section

C. Description of monument for corner and accessories established to perpetuate locating the position of the corner:

8		4			3		
N1/8 Cor. on E-W 1/4 line		Center of NW 1/4			N1/8 Cor. on W. Side		
Set 5/8" bar w/cap		Set 5/8" bar w/cap			Set 5/8" bar w/cap		
14" R. Pine	S78 E 10.80'	5" Balsam	N21 W	25.8'	5" Cedar	N48 E	14.0'
14" Twin R. Pine	S18 W 15.60'	4" W. Pine	S54 E	34.7'	5" Cedar	S10 E	17.9'
14" R. Pine	N87 W 25.84'	2" Pipe	S31 W	31.4'	3" pipe	S20 W	12.7'
SE Cor. Block Bldg.	N9 W 9.60'	4" W. Pine	N63 W	32.2'	12" Cedar	S34 W	9.9'
(nail & tag in trees)							

STATE OF MICHIGAN
CARL R. JOHNSON
LAND SURVEYOR
No. 30083
LICENSED LAND SURVEYOR

Signed by Carl R. Johnson Date 1-6-92

Surveyor's Michigan License No. 30083

FORM APPROVED BY MICHIGAN STATE BOARD OF LAND SURVEYORS, JAN. 28, 1971
REVISED MAY 14, 1975
REVISED JAN., 1983