LAND CORNER RECORDATION CERTIFICATE

Filing Requirement of Act 74, Mich. P.A. 1970

For corners in PRESQUE ISLE (County)

	Located In:	Corner Code ##
1. Public Land Survey	T 33N R 2E	C-9, C-10,
	T ___ R ___	C-11, D-11
	T ___ R ___	
	T ___ R ___	
2. Property Controlling	S ___ T ___ R ___	
in Section	S ___ T ___ R ___	
3. Miscellaneous	S ___ T ___ R ___	
Property in Sec.	S ___ T ___ R ___	

Register of Deeds Stamp & File Number

4. Lot No. _____ , Recorded Plat _____
5. Private Claims _____

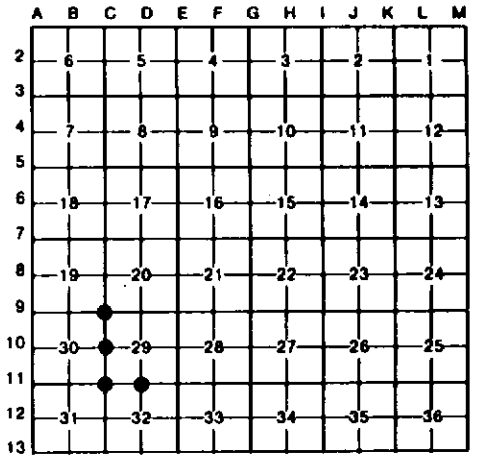

I, CARL T. KIISKILA, in a field survey on NOVEMBER 1, 19 95, do hereby certify that under requirements of P.A. 74, Michigan P.A. of 1970, the corner points mentioned in lines 1 and 2 above were in conformance with regulations and rules therefore as required in the current manual of survey instructions of the United States Department of the Interior, Bureau of Land Management or by a decree of a Court of Law and/or that the corner points mentioned in lines 3, 4 and 5 above were in conformance with the rules of the Michigan Board of Land Surveyors or by a Decree of a Court of Law; established, re-established, monumented, re-monumented, recovered, found as expressed below:

NOTE: Not more than 4 corners, all in the same town and range, may be recorded on this certificate.

A. Description of original monument and accessories and/or subsequent restoration:

C-9

(NO EVIDENCE OF G.L.O. CORNER, B.T'S, LINE TREES & TOPOGRAPHY, AS CALLED OUT IN THE G.L.O. LINE NOTES; UNLESS NOTED IN ITEM "B" BELOW.)

C-10

STATE OF MICHIGAN
CARL KIISKILA
LAND SURVEYOR
No. 33981
LICENSED LAND SURVEYOR

D-11

B. CONT.- FD POSSIBLE GLO STUMP 24"R.PINE N68°E 29.9', NO APPARENT SCRIBING BUT BLAZES ARE VISIBLE; US = Y.PINE 20 N63°E 45LKS (29.7').

B. Description of corner evidence found and/or method applied in restoring or reestablishing corner:

C-9

FD & ACCPETED A 2" PIPE W/CONC AS SET BY MICH DEPT OF CONS SURVEYOR MARCUS SCHAAF FOR THE NE COR OF SEC 30. THIS COR WAS ALSO ACCEPTED BY RLS DELMER PORTER AND SHELL OIL CO (PERLA STOUT & ASSOC 1978) DURING SUBSEQUENT SURVEYS. SMOOTH WIRE TO N & W.

C-10

FD & ACCEPTED A 2" PIPE AS SET BY MICH DEPT OF CONS SURVEYOR MARCUS SCHAAF FOR THE E 1/4 COR OF SEC 30. THIS COR WAS ALSO ACCEPTED AND USED DURING SUBSEQUENT SURVEYS BY RLS RONALD BISHCER AND SHELL OIL CO. SEE SHELL OIL CO DRAWING 78542 FOR MORE INFO. THE COR IS LOCATED IN THE CTR OF AN E-W & N-S TRAIL ROAD INTERSEC.

C-11

FD & ACCEPTED A 1 1/2" PIPE AS SET BY MICH DEPT OF CONSERVATION SURVEYOR MARCUS SCHAAF FOR THE SE COR OF SECTION 30. FD 3/4" PIPE AS RECORDED IN LIBER 1, PG 121 OF CORNER RECORDS BY LARRY M. GERSCHBACHER 0.50' TO THE NE. COR IS LOCATED 5' SW OF A N-S & E-W TRAIL ROAD INTERSECTION.

D-11

FD & ACCEPTED A 1 1/2" PIPE W/CONC AS SET BY MICH DEPT OF CONSERVATION SURVEYOR M. SCHAAF FROM POSSIBLE ORIGINAL B.T. STUMP. THIS COR WAS ALSO ACCEPTED AND USED DURING SUBSEQUENT SURVEYS BY RLS RONALD BISCHER AND SHELL OIL CO.(PERLA STOUT & ASSOC 1978.) SEE SHELL OIL CO DRAWING 78542 & R. BISCHER LCRC P 617 FOR MORE INFO. -- CONT. ABOVE-

C. Description of monument for corner and accessories established to perpetuate locating the position of the corner:

C-9

SET DNR MON INSIDE FD 2" I.P. SET CARSONITE POST 1' NORTH.

#9" J PINE	N54°W	17.73'
4" W PINE	S38°W	10.25'
4" W PINE	S53°E	16.34'
5" SPRUCE	N20°E	24.45'

#D.PORTER, P.S. #15410 WIT

C-10

FD 2" I.P, 6" BELOW GRADE, IN INTERSEC FIRELANE. SET 5/8"x 16" REROD W/CAP IN PIPE.

# 7" J PINE	S35°E	11.66'
4" OAK	S53°W	21.20'
10" OAK	N12°W	54.48'
10" OAK	N74°E	67.57'

#OLD WIT BY RLS R. BISCHER

C-11

FD 1 1/2" I.P, 12" BELOW GRADE, SET 5/8"x 16" REROD W/CAP INSIDE.

8" R PINE	S59°E	35.82'
6" J PINE	N60°E	52.08'
6" J PINE	N78°W	33.93'
5" R PINE	S36°W	54.45'
FD 3/4" PIPE	N45°E	0.50'

SET CARSONITE WEST SIDE OF N-S TRAIL.TRL

D-11

FD 1 1/2" PIPE 6" BELOW GROUND.

16" R PINE	N08°W	45.11'
#12" J PINE	N48°E	50.82'
#12" J PINE	S61°E	38.38'
12" J PINE	S52°W	37.91'

#OLD WIT BY RLS R. BISHCER

Signed by Carl T Kiiskila Date 4-3-96

Surveyor's Michigan License No. 33981

FORM APPROVED BY MICHIGAN STATE BOARD OF LAND SURVEYORS, JAN. 28, 1971
REVISED MAY 14, 1975
REVISED JAN., 1983