LAND CORNER RECORDATION CERTIFICATE

Filing Requirement of Act 74, Mich. P.A. 1970

For corners in PRESQUE ISLE (County)

	Located In:	Corner Code ##
1. Public Land Survey	T 33N R 2E	A-11
	T ___ R ___	
	T ___ R ___	
	T ___ R ___	
2. Property Controlling	S 30 T ___ R ___	10, 11, 15
in Section	S ___ T ___ R ___	
3. Miscellaneous	S ___ T ___ R ___	
Property in Sec.	S ___ T ___ R ___	

Register of Deeds Stamp & File Number

4. Lot No. _____ , Recorded Plat _____
5. Private Claims _____

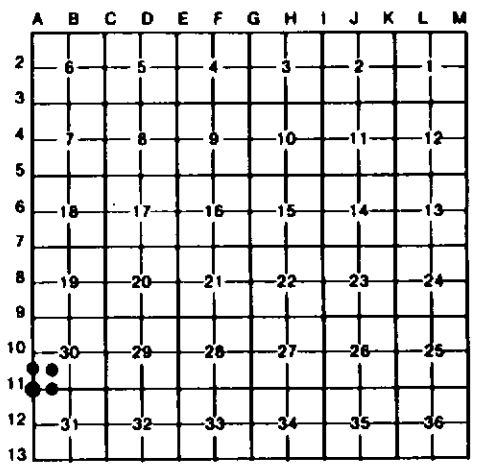

I, CARL T. KIISKILA, in a field survey on NOVEMBER 8, , 19 95, do hereby certify that under requirements of P.A. 74, Michigan P.A. of 1970, the corner points mentioned in lines 1 and 2 above were in conformance with regulations and rules therefore as required in the current manual of survey instructions of the United States Department of the Interior, Bureau of Land Management or by a decree of a Court of Law and/or that the corner points mentioned in lines 3, 4 and 5 above were in conformance with the rules of the Michigan Board of Land Surveyors or by a Decree of a Court of Law; established, re-established, monumented, re-monumented, recovered, found as expressed below:

NOTE: Not more than 4 corners, all in the same town and range, may be recorded on this certificate.

A. Description of original monument and accessories and/or subsequent restoration:

A-11 10 11 15

(NO EVIDENCE OF G.L.O. CORNER, B.T'S, LINE TREES & TOPOGRAPHY, AS CALLED OUT IN THE G.L.O. LINE NOTES; UNLESS NOTED IN ITEM "B" BELOW.)

STATE OF MICHIGAN
CARL KIISKILA
LAND SURVEYOR
No. 33981
LICENSED LAND SURVEYOR

B. Description of corner evidence found and/or method applied in restoring or reestablishing corner:

A-11	10	11	15
FD & ACCEPTED A 2" PIPE W/CONC AS SET BY MICH DEPT OF CONSERVATION SURVEYOR MARCUS SCHAAF FOR THE NW COR OF SECTION 31. THIS COR WAS ALSO USED DURING SUBSEQUENT SURVEYS BY SHELL OIL CO.(PERLA STOUT & ASSOC.).	ESTABLISHED THE SW COR OF THE FRACTIONAL NW 1/4 OF THE FRACTIONAL SW 1/4 SEC 30 BY STANDARD BLM PROCEDURE FOR SUBDIVISION OF A SECTION.	ESTABLISHED THE SW COR OF THE NE 1/4 OF THE FRACTIONAL SW 1/4 SEC 30 BY STANDARD BLM PROCEDURES FOR SUBDIVISION OF A SECTION.	FD & ACCEPTED A 1 1/2" PIPE W/CONC AS SET BY MICH DEPT OF CONSERVATION SURVEYOR MARCUS SCHAAF FOR THE SW COR OF THE SE 1/4 OF THE FRAC SW 1/4 SEC 30. CORNER FALLS IN LARGE MARSH WITH NO TREES TO WITNESS TO.

C. Description of monument for corner and accessories established to perpetuate locating the position of the corner:

A-11			10			11			15		
FD 2" PIPE W/CONC. SET 5/8" REBAR INSIDE.			SET 5/8"x 32" REROD W/CAP & SET CARSONITE POST 1' N.			SET 5/8"x 32" REROD W/CAP & SET CARSONITE POST 1' N.			FD 1 1/2" PIPE.		
									CTR 10' WIDE CRK	DUE S	29'
10" CEDAR	N26°W	27.04'	12" R PINE	N18°W	90.34'	9" R PINE	S55°W	36.67'	SET CARSONITE POST	DUE N	1'
5" SPRUCE	DUE W	12.53'	8" OAK	S87°W	30.28'	7" J PINE	S47°E	24.94'	E-W BRUSHED LINE	DUE N	13'
4" SPRUCE	S23°E	19.73'	8" J PINE	S34°E	45.32'	5" J PINE	N50°E	24.05'	CTR N-S 6'WIDE CRK	DUE E	54'
13" CEDAR	N82°E	10.48'	6" J PINE	N06°E	72.41'	6" SPRUCE	N59°W	27.91'			

Signed by Carl T Kiiskila Date 4-3-96

Surveyor's Michigan License No. 33981

FORM APPROVED BY MICHIGAN STATE BOARD OF LAND SURVEYORS, JAN. 20, 1971
REVISED MAY 14, 1975
REVISED JAN., 1983