LAND CORNER RECORDATION CERTIFICATE

Filing Requirement of Act 74, Mich. P.A. 1970

For corners in
PRESQUE ISLE
(County)

	Located In:	Corner Code ##
1. Public Land Survey	T 33N R 2E	A-13, B-13
	T ____ R ____	C-13
	T ____ R ____	
	T ____ R ____	
2. Property Controlling	S 31 T ____ R ____	10
in Section	S ____ T ____ R ____	
3. Miscellaneous	S ____ T ____ R ____	
Property in Sec.	S ____ T ____ R ____	

Register of Deeds Stamp & File Number

4. Lot No. _____ , Recorded Plat _____
5. Private Claims _____

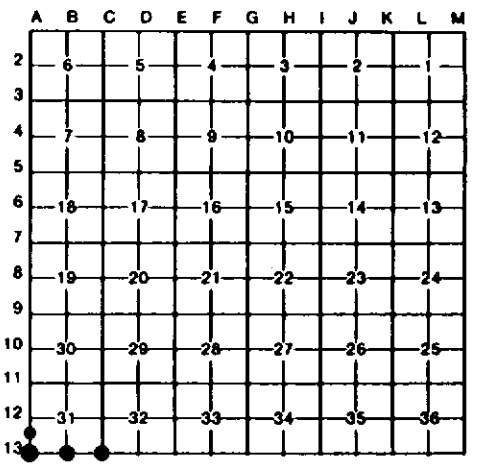

I, CARL T. KIISKILA , in a field survey on NOVEMBER 14, , 19 95 , do hereby certify that under requirements of P.A. 74, Michigan P.A. of 1970, the corner points mentioned in lines 1 and 2 above were in conformance with regulations and rules therefore as required in the current manual of survey instructions of the United States Department of the Interior, Bureau of Land Management or by a decree of a Court of Law and/or that the corner points mentioned in lines 3, 4 and 5 above were in conformance with the rules of the Michigan Board of Land Surveyors or by a Decree of a Court of Law; established, re-established, monumented, re-monumented, recovered, found as expressed below:

NOTE: Not more than 4 corners, all in the same town and range, may be recorded on this certificate.

A. Description of original monument and accessories and/or subsequent restoration:

A-13 B-13 C-13 10

(NO EVIDENCE OF G.L.O. CORNER, B.T'S, LINE TREES & TOPOGRAPHY, AS CALLED OUT IN THE G.L.O. LINE NOTES; UNLESS NOTED IN ITEM "B" BELOW.)

STATE OF MICHIGAN
CARL KIISKILA
LAND SURVEYOR
No. 33981
LICENSED LAND SURVEYOR

B. Description of corner evidence found and/or method applied in restoring or reestablishing corner:

A-13
FD 2" PIPE FOR SW COR OF S-31 AS PROBABLY SET BY CONS DEPT SURVEYOR M. SCHAAF. FOUND 26" Y. PINE STP (BURNT) N53°W, 20.0'; US=Y. PINE 24 N58°W 30 LKS (19.8'). SMOOTH WIRE FN TO E & W

B-13
FD & ACCEPTED A 1 1/2" PIPE AS SET BY MICH DEPT OF CONS SURVEYOR MARCUS SCHAAF FOR THE S 1/4 COR OF SECTION 31. CTR E-W TRAIL RD IS 16' SOUTH. COR IS LOCATED IN THE CTR OF TRAIL RD TO N.

C-13
FD & ACCEPTED A 2" PIPE W/CONC WITH A 1/2" IR & RLS CAP 12581 DRIVEN IN THE CTR. THE 2" PIPE WAS SET BY MICH DEPT OF CONS SURVEYOR MARCUS SCHAAF FOR THE SE COR OF SEC 31. THIS CORNER WAS ALSO ACCEPTED BY SHELL OIL CO (PERLA STOUT & ASSOC) DURING SUBSEQUENT SURVEYS. THE COR IS AT THE S EDGE OF TRAIL TO THE EAST & EAST EDGE OF A TRAIL TO THE N.

10
FD & ACCEPTED A 1 1/2" PIPE AS SET BY MICH DEPT OF CONS SURVEYOR MARCUS SCHAAF FOR THE SW COR OF THE FRAC NW 1/4 OF THE FRAC SW 1/4. SE COR OF CLEARCUT IS 10' NORTH.

C. Description of monument for corner and accessories established to perpetuate locating the position of the corner:

A-13
FD 2" I.P. SET CARSONITE POST.

10" J PINE	N21°W	15.97'
8" J PINE	N48°E	42.08'
8" J PINE	S11°E	65.10'
20" H PINE	S42°W	66.14'

B-13
FD 1 1/2" PIPE W/CONC SET 5/8 REBAR W/CAP INSIDE. SET CARSONITE POST 1' N.

9" OAK	N13°W	32.42'
4" W PINE	N89°E	29.52'
5" R PINE	S10°W	22.97
7" OAK	S88°W	18.97'

C-13
FD 2" PIPE W/CONC & 1/2" IRON. SET CARSONITE POST 5' WEST.

#6" J PINE	S12°E	28.25'
#7" J PINE	N70°W	5.12'
#6" J PINE	N19°E	24.95'
6" J PINE	S75°E	26.87'

#PERLA STOUT & ASSOC WIT.

10
FD 1 1/2" I.P. SET 5/8"x 32" REROD W/ CAP INSIDE PIPE. SET CARSONITE POST 1' NORTH.

2" BALSAM	S33°E	23.95'
24" R PINE	S80°W	31.73'
4" W PINE	N67°W	40.14'
4" R PINE	N43°E	29.71'

Signed by Carl T Kiiskila Date 4-3-96

Surveyor's Michigan License No. 33981

FORM APPROVED BY MICHIGAN STATE BOARD OF LAND SURVEYORS, JAN. 28, 1971
REVISED MAY 14, 1975
REVISED JAN., 1983