

LAND CORNER RECORDATION CERTIFICATE
Filing Requirement of Act 74, Mich. P.A. 1970

For corners in

Presque Isle <small>(County)</small>	Located In:	Corner Code //
1 Public Land Survey	T 33NR 4E	F-10
	T 33NR 4E	F-11
	T R	
	T R	
2 Property Controlling in Section	S 28 T 33NR 4E	9
	S 28 T 33NR 4E	16
3 Miscellaneous Property in Sec.	S T R	
	S T R	
4 Lot No	Recorded Plat	
5 Private Claims		

Register of Deeds Stamp & File Number

	A	B	C	D	E	F	G	H	I	J	K	L	M
2	6	5	4	3	2	1							
3													
4	7	8	9	10	11	12							
5													
6	18	17	16	15	14	13							
7													
8	19	20	21	22	23	24							
9													
10	30	29	28	27	26	25							
11													
12	31	32	33	34	35	36							
13													

I, **Carl R. Johnson**, in a field survey on **July 12,** 19 **84**, do hereby certify that under requirements of P.A. 74, Michigan P.A. of 1970, the corner points mentioned in lines 1 and 2 above were in conformance with regulations and rules therefore as required in the current manual of survey instructions of the United States Department of the Interior, Bureau of Land Management or by a decree of a Court of Law and/or that the corner points mentioned in lines 3, 4 and 5 above were in conformance with the rules of the Michigan Board of Land Surveyors or by a Decree of a Court of Law, established, re-established, monumented, re-monumented, recovered, found as expressed below

NOTE: Not more than 4 corners, all in the same town and range, may be recorded on this certificate.

A. Description of original monument and accessories and/or subsequent restoration:

B. Description of corner evidence found and/or method applied in restoring or reestablishing corner:

F-10 - Set corner by standard survey procedure, at the intersection of the true $\frac{1}{4}$ lines.

F-11 - Set corner by proportionate measurement between section corners.


9 - Set by standard survey procedure for the subdivision of sections.

16 - Set by standard survey procedure for the subdivision of sections.

C. Description of monument for corner and accessories established to perpetuate locating the position of the corner:

<u>F-10</u>		<u>9</u>
Set DNR Mon.		Set 5/8" x 30" iron bar.
12" Cedar N85°E 93.4'		12" Cedar S64°W 6.6'
10" Cedar N52°E 88.0'		6" Cedar S82°E 16.8'

<u>F-11</u>		<u>16</u>
Set DNR Mon.		Set 5/8" x 30" iron bar.
8" Red Oak S74°E 9.3'		8" Red Oak N87°E 26.7'
14" Red Oak N28°W 33.0'		11" Red Oak S51°W 40.8'

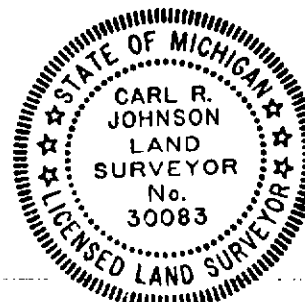

Signed by *Carl R. Johnson*
 Surveyor's Michigan License No. 30083

Date *6/16/84*