

LAND CORNER RECORDATION CERTIFICATE
Filing Requirement of Act 74, Mich. P.A. 1970

For corners in

<u>Presque Isle</u> <small>(County)</small>	Located In:	Corner Code \neq
1. Public Land Survey	T _____ R _____	_____
	T _____ R _____	_____
	T _____ R _____	_____
	T _____ R _____	_____
2. Property Controlling in Section	S <u>35</u> T <u>33N</u> R <u>4E</u>	<u>2</u>
	S <u>35</u> T <u>33N</u> R <u>4E</u>	<u>8</u>
3. Miscellaneous Property in Sec.	S _____ T _____ R _____	_____
	S _____ T _____ R _____	_____

Register of Deeds Stamp & File Number

4. Lot No. _____, Recorded Plat _____
 5. Private Claims _____

I, Carl R. Johnson, in a field survey on September 1, 19 87, do hereby certify that under requirements of P.A. 74, Michigan P.A. of 1970, the corner points mentioned in lines 1 and 2 above were in conformance with regulations and rules therefore as required in the current manual of survey instructions of the United States Department of the Interior, Bureau of Land Management or by a decree of a Court of Law and/or that the corner points mentioned in lines 3, 4 and 5 above were in conformance with the rules of the Michigan Board of Land Surveyors or by a Decree of a Court of Law; established, re-established, monumented, re-monumented, recovered, found as expressed below:


NOTE: Not more than 4 corners, all in the same town and range, may be recorded on this certificate.

	A	B	C	D	E	F	G	H	I	J	K	L	M
2	6		5		4		3		2		1		
3													
4	7		8		9		10		11		12		
5													
6	18		17		16		15		14		13		
7													
8	19		20		21		22		23		24		
9													
10	30		29		28		27		26		25		
11													
12	31		32		33		34		35		36		
13													

- A. Description of original monument and accessories and/or subsequent restoration:
- B. Description of corner evidence found and/or method applied in restoring or reestablishing corner:
- 2 - Set by standard procedure for subdivision of a section.
 - 8 - Set by standard procedure for subdivision of a section.

- C. Description of monument for corner and accessories established to perpetuate locating the position of the corner:
- | | |
|------------------------------|--------------------------------|
| <u>2 - E 1/8, North Side</u> | <u>8 - W 1/8, E-W 1/2 Line</u> |
| <u>5/8" bar w/cap</u> | <u>5/8" bar w/cap</u> |
| Maple 4" S14°W 7.4' | Red Oak 8" N60°W 31.0' |
| Maple 6" S69°E 25.4' | White Birch 8" N83°E 10.0' |
| Maple 6" N31°W 25.5' | Maple 6" S13°E 9.7' |

Signed by Carl R. Johnson

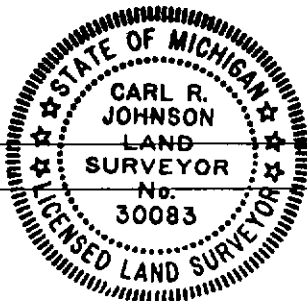

Date 1/4/88