

LAND CORNER RECORDATION CERTIFICATE
Filing Requirement of Act 74, Mich. P.A. 1970

For corners in

<u>Presque Isle</u> <small>(County)</small>	Located In:	Corner Code #
1. Public Land Survey	T <u>33N</u> R <u>4E</u>	<u>J-10</u>
	T <u>33N</u> R <u>4E</u>	<u>J-13</u>
	T _____ R _____	_____
	T _____ R _____	_____
2. Property Controlling in Section	S <u>26</u> T <u>33N</u> R <u>4E</u>	<u>8</u>
	S <u>26</u> T <u>33N</u> R <u>4E</u>	<u>15</u>
3. Miscellaneous Property in Sec.	S _____ T _____ R _____	_____
	S _____ T _____ R _____	_____

Register of Deeds Stamp & File Number

4. Lot No. _____, Recorded Plat _____
 5. Private Claims _____

I, Carl R. Johnson, in a field survey on June 29, 1987, do hereby certify that under requirements of P.A. 74, Michigan P.A. of 1970, the corner points mentioned in lines 1 and 2 above were in conformance with regulations and rules therefore as required in the current manual of survey instructions of the United States Department of the Interior, Bureau of Land Management or by a decree of a Court of Law and/or that the corner points mentioned in lines 3, 4 and 5 above were in conformance with the rules of the Michigan Board of Land Surveyors or by a Decree of a Court of Law; established, re-established, monumented, re-monumented, recovered, found as expressed below:

NOTE: Not more than 4 corners, all in the same town and range, may be recorded on this certificate.

	A	B	C	D	E	F	G	H	I	J	K	L	M
2	6	5	4	3	2	1							
3													
4	7	8	9	10	11	12							
5													
6	18	17	16	15	14	13							
7													
8	19	20	21	22	23	24							
9													
10	30	29	28	27	26	25							
11													
12	31	32	33	34	35	36							
13													

A. Description of original monument and accessories and/or subsequent restoration:

B. Description of corner evidence found and/or method applied in restoring or reestablishing corner:
J-10 - Set by standard survey procedure for subdivision of a section.

J-13 - Set corner on occupation line (fence corner) no evidence of original or subsequent survey.

8 - Set corner by standard survey procedure for subdivision of a section.

15 - Set by standard survey procedure for subdivision of a section.

C. Description of monument for corner and accessories established to perpetuate locating the position of the corner:


J-10 - Center of Section
 Set 5/8" bar & cedar post
 4" W. pine N13°W 67.2'
 10" R. Pine N61°E 29.9'
 12" R. Oak S57°W 14.5'

J-13 - S 1/2 Corner
 DNR Mon.
 Fence Post S86°E 9.02'
 Fence Post S 9°W 10.31'

8 - W 1/8 Cor. on E-W Line
 Set 5/8" bar & cedar post
 6" cedar N44°E 44.2'
 12" cedar N59°W 53.6'

15 - W 1/8 Corner on S. Side
 Set 5/8" bar & cedar post
 6" W. Pine N48°E 32.9'
 5" Maple S24°W 19.6'

Signed by Carl R. Johnson

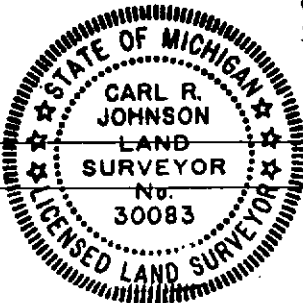

Date 1/4/88

Surveyor's Michigan License No. 30083