LAND CORNER RECORDATION CERTIFICATE

Filing Requirement of Act 74, Mich. PA 1970

For Corners In:
Presque Isle
(County)

		Located In		Corner Code #
1. Public Land Survey		T 33N	R 4E	C-8
		T 33N	R 4E	C-7
2. Property Controlling in Section	S	T	R	
	S	T	R	
3. Miscellaneous Property in Section	S	T	R	
	S	T	R	

Register of Deeds Stamp & File Number

4. Lot No: _____ Recorded Plat: _____

5. Private Claims: _____

I, Carl T. Kiiskila, in a field survey on May 6, 2002 do hereby state that under requirements of PA 74, Michigan PA of 1970, the corner points mentioned in lines 1 and 2 above were in conformance with regulations and rules therefore as required in the current manual of survey instructions of the United States Department of the Interior, Bureau of Land Management or by a decree of a Court of Law and/or that the corner points mentioned in lines 3, 4 and 5 above were in conformance with the rules of the Michigan Board of Land Surveyors or by a Decree of a Court of Law; established, re-established, monumented, recovered, found as expressed below:

NOTE: Not more than 2 corners, all in the same town and range, may be recorded on this certificate.

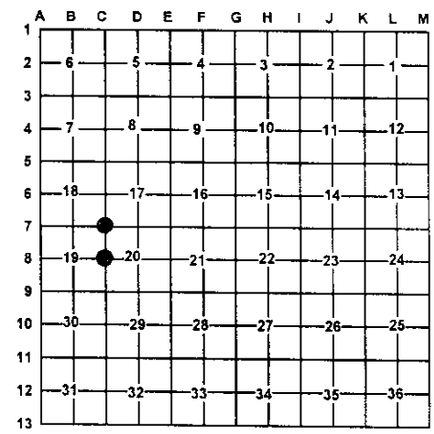

A. Description of original monument and accessories and/or subsequent restoration:

C-8 G.L.O. Alfred Millerd 1855 set quarter section post
Wit: Spruce Pine 10 N40°W 21 links
Spruce Pine 12 S58°E 38 links

Page 318, Presque Isle County Land Corner Records November 1978, Delmer E. Porter P.S. #15410 Found a 1" Pipe set by G. Delamater. D. Porter set a concrete monument with brass cap.
Wit: N44°E 93.60' 8" N.B.T. Stump
S24°E 16.35' 14" J. Pine
S54°W 26.31' 10" J. Pine

C-7 G.L.O. Alfred Millerd 1855 set section post
Wit: Yellow Pine 11 N33°W 42 links
Yellow Pine 11 S35°E 33 links

Gregory Shadko R.L.S. and P.E. #1934 set a Michigan Department of Conservation Monument for the corner while doing work in the area in June of 1943. No witnesses were given.

B. Description of corner evidence found and/or method applies in restoring or re-establishing corner:

C-8 Found Presque Isle County Monument.

C-7 Found Department of Conservation monument.

C. Description of monument for corner and accessories established to perpetuate locating the position of the corner:

C-8 Found Presque Isle County Monument.

Wit: 4" Jack Pine	N44°E	8.05'
4" Jack Pine	N52°E	30.96'
8" Red Pine	S38°E	17.68'
14" Red Pine Stump	S56°W	15.06'
Fence Corner post	S65°E	18.0'±
Carsonite Post	North	1'±

C-7 Found Department of Conservation monument.

Wit: 20" Oak	S69°W	41.92'
18" Red Pine	N49°W	28.84'
8" Red Pine	S26°E	18.39'
10" Maple	N32°E	14.02'
Carsonite Post	North	1'±

Signed by: Carl T Kiiskila

Date: 8-26-02

Surveyor's Michigan License No.: 33981

STATE OF MICHIGAN
CARL KIISKILA
LAND SURVEYOR
No. 33981
LICENSED LAND SURVEYOR

FORM APPROVED BY MICHIGAN STATE BOARD OF PROFESSIONAL SURVEYORS JAN. 28, 1971
Revised May 14, 1975
Revised Jan. 1983
Revised Oct. 1995